

Registration Statement

OF CLAIMANT OF RIGHT TO APPROPRIATE GROUND WATER

TO THE STATE ENGINEER OF OREGON:

I, Leon H. Funke and/or Flossie Funke
of Rt. 2, Box 366, Eugene County of Lane
(Mailing address)

State of Oregon do hereby make application for a certificate of registration as evidence of a right to appropriate ground water.

1. Source from which water is withdrawn is pump well
(Flowing well, pump well, infiltration trench, or tunnel)

2. Location is: One mile S. of Coburg School House
(Approximate distance and direction from nearest city or town)

and is more particularly described as follows:

(a) S. 650'; W. 2100' from the N. E. corner of Sec 5, T 17 S; R 3 W
(Give distance and bearing to corner of section or other legal subdivision)

being within NW 1/4 of Sec. 5, Twp. 17 S, Rge. 3 W
(Smallest legal subdivision) (N. or S.) (E. or W.)

or (b) within limits of recorded platted property, town or city:

in Lot _____, Block _____ of _____
(Name of plat or addition)

County of _____
(If within city or town, give name)

3. Construction Work was begun on _____; was completed on _____
(Date) (Date)

and the ground water claimed was first used for the purposes set out below on _____
(Date)

since which time the water has been used _____
(Continuously or Intermittently)

from April to October each year
(Date) (Date)

4. Quantity of water claimed and used is 400 gallons per minute; 82 acre feet per year.

5. Purpose or Purposes for which water is used Irrigation
(Domestic, irrigation, municipal, manufacturing, industrial, etc.)

6. Description of Well: Depth _____ feet. Type _____
(Dug or drilled)

1 (2") & 3 (2") pipes coupled together diameter _____ inches. Elevation of ground at well site _____ feet, mean sea level.
(As near as known)

Depth to water table _____ feet.

7. Capacity of Well: _____ g.p.m. with _____ feet drawdown.

_____ g.p.m. with _____ feet drawdown.

Date of test None made


If Flowing Well: Measured discharge _____ g.p.m. on _____
(Date)

Shut-in pressure at ground surface _____ lbs. per sq. in. on _____
(Date)

Water is controlled by _____
(Cap, valve, etc.)

SEE MAP ATTACHED

Township 17S Range 3W, W.M.
North

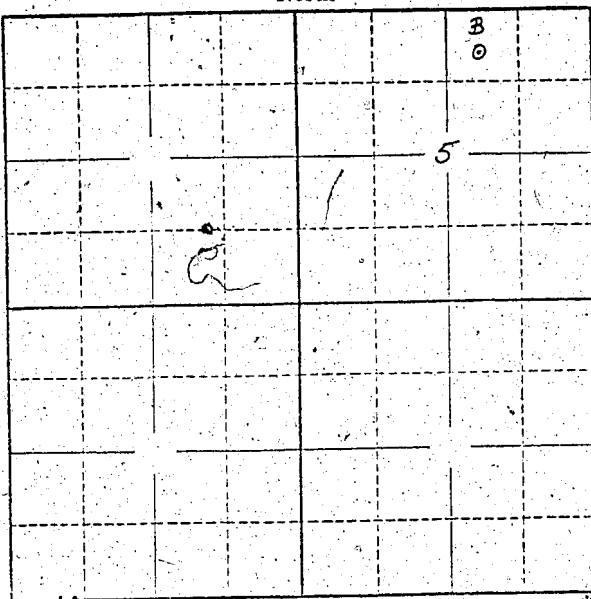

Locate well and acreage of irrigated land on plat.
Scale: 2" = 1 Mile

STATE OF OREGON

County of Lane } ss.

I, Leon H. Funk and/or Flossie Funk, being first duly sworn, do hereby certify that I have read the foregoing Registration Statement and that all of the items therein contained are true to the best of my knowledge and belief.

Leon H. Funk and/or Flossie Funk
(Signature of Registrant)

Subscribed and sworn to before me this 29th day of July, 1957

My commission expires May 14, 1960
(Notary Public)

(SEAL)

CERTIFICATE OF REGISTRATION

STATE OF OREGON

County of Marion } ss.

This is to certify that the foregoing Registration Statement was received in the office of the State Engineer on the 30th day of July, 1958, at 9⁰⁰ o'clock A. M. and has been duly recorded in said office in Book No. 13 of Registration Statements on page GR-2999

Witness my hand this 2nd day of June, 1959

Lewis A. Stanley
(State Engineer)

By _____ (Deputy)

15-45

GR-2999