

Registration Statement

OF CLAIMANT OF RIGHT TO APPROPRIATE GROUND WATER

Well # 4

TO THE STATE ENGINEER OF OREGON:

I, LEON H. FUNKE AND/OR FLOSSIE FUNKE
 of ROUTE 2 EUGENE County of LANE
(Mailing address)
 State of OREGON do hereby make application for a certificate of registration as evidence
 of a right to appropriate ground water.

1. Source from which water is withdrawn is Home Farm Pump Well #4
(Flowing well, pump well, infiltration trench, or tunnel)
2. Location is: 1/2 MILE SOUTH OF CORBURG SCHOOL HOUSE
(Approximate distance and direction from nearest city or town)

and is more particularly described as follows:

(a) 1780 ft N. & 1900 ft W. from the SW corner of the SE 1/4 SE 1/4 of section 32
(Give distance and bearing to corner of section or other legal subdivision)
 being within NE 1/4 SW 1/4 of Sec. 32, Twp. 16 S, Rge. 3 W
(Smallest legal subdivision) (N. or S.) (E. or W.)

or (b) within limits of recorded platted property, town or city: _____
 in Lot _____, Block _____ of _____
(Name of plat or addition)
 County of LANE
(If within city or town, give name)

3. Construction Work was begun on 1938; was completed on 1938
(Date) (Date)
 and the ground water claimed was first used for the purposes set out below on 1938
(Date)
 since which time the water has been used _____
(Continuously or intermittently)

from APRIL to OCTOBER Each year
(Date) (Date)

4. Quantity of water claimed and used is 360 gallons per minute; 75 acre
 feet per year.

5. Purpose or Purposes for which water is used IRRIGATION
(Domestic, irrigation, municipal, manufacturing, industrial, etc.)

6. Description of Well: Depth 21 feet. Type DRIVE
(Dug or drilled)
 diameter 3(2") inches. Elevation of ground at well site 390 feet, mean sea level.
(As near as known)
 Depth to water table 12 feet.

7. Capacity of Well: _____ g.p.m. with _____ feet drawdown.
 _____ g.p.m. with _____ feet drawdown.

Date of test No TEST

If Flowing Well: Measured discharge _____ g.p.m. on _____
(Date)

Shut-in pressure at ground surface _____ lbs. per sq. in. on _____
(Date)

Water is controlled by _____
(Cap. valve, etc.)

8. Casing: (Give diameter, commercial specifications and depth below ground surface of each casing size.)

3(2") inch diameter from 0 to 21 feet
 inch diameter from to feet
 inch diameter from to feet
 inch diameter from to feet

Describe and show depth of shoe, plug, adapter, liner or other details:

9. Perforated Casings or Screens:

HOLES 1/8" 16 per ft. from 17 1/2 to 21
(Number per foot and size of perforations, or describe screen)
 from to
 from to
 from to

10. Log of Well: (Describe each stratum or formation clearly, indicate if water bearing, and give thickness and depth as indicated.)

MATERIAL	Thickness (Feet)	Depth to Bottom (Feet)
NONE		

If log of well is not available, give name and address of driller. OWNER

11. Infiltration Trench: Covered or open

Dimensions: Length ft. Minimum depth ft. Maximum depth ft.

Bottom width ft. Discharge g.p.m. Date of test

12. Tunnel: Type of lining

Dimensions:
(Length, course, and cross sectional size).

Position of water bearing stratum with reference to portal of tunnel

Log of tunnel: (Preceding table for log of well may be used, if desired. Give footage from portal and character of materials, as pertinent.)

13. Pumping Equipment:

(a) Pump ALLIS CHALMERS CENT. 4" x 3 1/2" Capacity 360 g.p.m.
(Make, type and size)

(b) Motor 15 HP - ELECTRIC 3 PHASE
(Type and horsepower)

14. Location of area irrigated or to be irrigated, or place of use if for purposes other than irrigation.


Township North, or South	Range E. or W. of Willamette Meridian	Section	Forty-acre Tract	Number Acres To Be Irrigated	Date of Reclamation
165	3W	32	NE 1/4 SW 1/4	20 ⁰	1938
165	3W	32	NW 1/4 SE 1/4	3	1938
165	3W	32	SW 1/4 SE 1/4	2	1938
165	3W	32	SE 1/4 SW 1/4	5	1938
				<u>30⁰ Ac</u>	

15. If the ground water supply is supplemental to an existing water supply, identification of any application for a permit, permit, certificate or adjudicated right to appropriate water made or held by the registrant.

All 4 wells supplement one another at one time or another

SEE ATTACHED MAP

Township 16.5 Range 3W W.M.
North

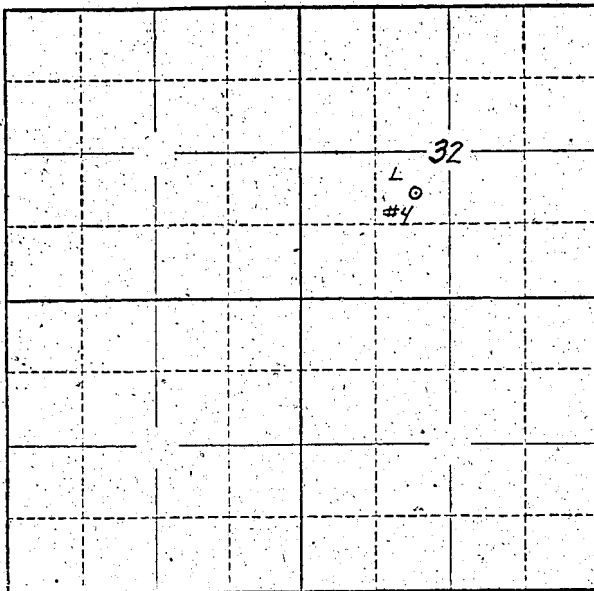

Locate well and acreage of irrigated land on plat.
Scale: 2" = 1 Mile

STATE OF OREGON

County of Lane } ss.

I, Leon H. Fankhauser & Flossie Fankhauser, being first duly sworn, do hereby certify that I have read the foregoing Registration Statement and that all of the items therein contained are true to the best of my knowledge and belief.

Leon H. Fankhauser
(Signature of Registrant)

Subscribed and sworn to before me this 27th day of July, 1958

My commission expires [blank] (Notary Public)

(SEAL)

CERTIFICATE OF REGISTRATION

STATE OF OREGON } ss.
County of Marion

This is to certify that the foregoing Registration Statement was received in the office of the State Engineer on the 30th day of July, 1958, at 9:00 o'clock A.M. and has been duly recorded in said office in Book No. 13 of Registration Statements on page GR-3003.

Witness my hand this 2nd day of June, 1958

Leura A. Stanley
(State Engineer)

By [blank] (Deputy)

GR - 3003

1/500