

Registration Statement

OF CLAIMANT OF RIGHT TO APPROPRIATE GROUND WATER

Distillery well

TO THE STATE ENGINEER OF OREGON:

I, Leon H. Funke and/ or Flossie Funke

of Rt. 2, Box 300, Eugene County of Lane
(Mailing address)

State of Oregon, do hereby make application for a certificate of registration as evidence of a right to appropriate ground water.

1. Source from which water is withdrawn is pump well - Distillery Well
(Flowing well, pump well, infiltration trench, or tunnel)

2. Location is: 1/2 mile S. of Coburg School House
(Approximate distance and direction from nearest city or town)

and is more particularly described as follows:

(a) N. 1005' ; W. 500' from the SE corner of the SW 31, Sec. 32
(Give distance and bearing to corner of section or other legal subdivision)

being within SE of Sec. 32, Twp. 10 S Rge. 3 E
(Smallest legal subdivision) (N. or S.) (E. or W.)

or (b) within limits of recorded platted property, town or city:

in Lot _____, Block _____ of _____
(Name of plat or addition)

County of _____
(If within city or town, give name)

3. Construction Work was begun on 1926; was completed on _____
(Date) (Date)

and the ground water claimed was first used for the purposes set out below on _____
(Date)

since which time the water has been used intermittently
(Continuously or intermittently)

from July to OCTOBER 31st each year
(Date) (Date)

4. Quantity of water claimed and used is 35 gallons per minute; 1440 acre feet per year.

5. Purpose or Purposes for which water is used Distillery - remainder, etc.

(Domestic, irrigation, municipal, manufacturing, industrial, etc.) 2 PIPES 4 FT APART AND ONE PIPE 50 FT.

6. Description of Well: Depth 21 feet. Type driven (3 pipes 3' apart)
(Dug or drilled)

diameter 2 (1 1/2" x 1 1/2") pipes - coupled together inches. Elevation of ground at well site _____ feet, mean sea level.
(As near as known)

Depth to water table _____ feet. 2 PIPES DRIVEN ABOUT 4 FT. APART AND 1 PIPE ABOUT 50 FT. FROM THE 2 PIPES OR WELLS

7. Capacity of Well: _____ g.p.m. with _____ feet drawdown.

_____ g.p.m. with _____ feet drawdown.

Date of test not tested

If Flowing Well: Measured discharge _____ g.p.m. on _____
(Date)

Shut-in pressure at ground surface _____ lbs. per sq. in. on _____
(Date)

Water is controlled by _____
(Cap. valve, etc.)

If log of well is not available, give name and address of driller:

11. Infiltration Trench: Covered or open

Dimensions: Length ft. Minimum depth ft. Maximum depth ft.

Bottom width ft. Discharge g.p.m. Date of test

12. Tunnel: Type of lining

Dimensions:
(Length, course, and cross sectional size)

Position of water bearing stratum with reference to portal of tunnel

Log of tunnel: (Preceding table for log of well may be used, if desired. Give footage from portal and character of materials, as pertinent.)

13. Pumping Equipment: Three small pumps hooked together, one from each well to deliver 75 g.p.m. through one pipe to a single outlet of use.

(a) Pump (1) Fairbanks Morse ^{PISTON} 3 1/4" elec.; 1 hp. Capacity 35 g.p.m.

(2) " " ; " ^(Make, type and size) 3 1/4" elec.; 3/4 hp

(b) Motor (3) Myers ; " ^(Type and horsepower) 3 1/4" elec.; 3/4 hp


14. Location of area irrigated or to be irrigated, or place of use if for purposes other than irrigation.

Township North or South	Range E. or W. of Willamette Meridian	Section	Forty-acre Tract	Number Acres To Be Irrigated	Date of Reclamation
16 S	3 W	32	NW 1/4 SE 1/4	none	1926

15. If the ground water supply is supplemental to an existing water supply, identification of any application for a permit, permit, certificate or adjudicated right to appropriate water made or held by the registrant.

SEE ATTACHED MAP

Township 16 S Range 9 W W.M.
North

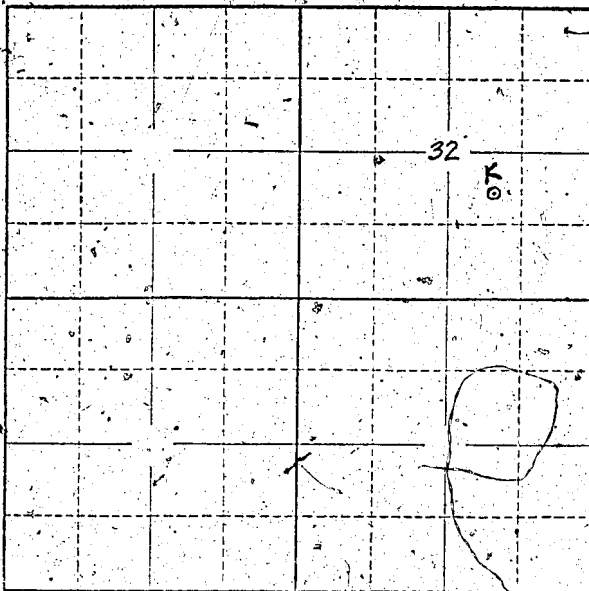

Locate well and acreage of irrigated land on plan.

Scale: 2" = 1 Mile

STATE OF OREGON

County of _____ Land _____

ss.

I, Leon H. Funke and/or Flossie Funke, being first duly sworn, do hereby certify that I have read the foregoing Registration Statement and that all of the items therein contained are true to the best of my knowledge and belief.

Leon H. Funke and/or Flossie Funke
(Signature of Registrant)

Subscribed and sworn to before me this 29th day of July, 1959

My commission expires March 14, 1960
(Notary Public)

(SEAL)

CERTIFICATE OF REGISTRATION

STATE OF OREGON

County of Marion } ss.

This is to certify that the foregoing Registration Statement was received in the office of the State Engineer on the 30th day of July, 1958, at 9:00 o'clock A. M. and has been duly recorded in said office in Book No. 13 of Registration Statements on page GR-3004

Witness my hand this 2nd day of June, 1959

Howard A. Stanley
(State Engineer)

By _____

(Deputy)

\$20.00

GR - 3004