

Registration Statement

OF CLAIMANT OF RIGHT TO APPROPRIATE GROUND WATER

Well # 1

TO THE STATE ENGINEER OF OREGON: ABLE PLACE

I, Leon H. Funke and/or Flossie Funke
of Rt. 2, Box 360, Eugene, Oregon County of Lane
(Mailing address)

State of Oregon, do hereby make application for a certificate of registration as evidence of a right to appropriate ground water.

1. Source from which water is withdrawn is Pump Well
(Flowing well, pump well, infiltration trench, or tunnel)

2. Location is: One mile S. of the Coburn School House
(Approximate distance and direction from nearest city or town)

and is more particularly described as follows:

(a) S. 400'; W. 750' from the N.E. corner of Sec 5; T 17 S; R3W
(Give distance and bearing to corner of section or other legal subdivision)

being within NE 1/4 of Sec. 5 Twp. 17 S Rge. 3 W.
(Smallest legal subdivision) (N. or S.) (E. or W.)

or (b) within limits of recorded platted property, town or city:

in Lot, Block of
(Name of plat or addition)

County of
(If within city or town, give name)

3. Construction Work was begun on 1951; was completed on 1951
(Date) (Date)

and the ground water claimed was first used for the purposes set out below on 1951
(Date)

since which time the water has been used Intermittently
(Continuously or Intermittently)

from April to October each year
(Date) (Date)

4. Quantity of water claimed and used is 260 gallons per minute; 58.53 acre feet per year.

5. Purpose or Purposes for which water is used Irrigation
(Domestic, irrigation, municipal, manufacturing, industrial, etc.)

6. Description of Well: Depth 27 feet. Type Incon
(Dug or drilled)

1 (3") & 2 (2") pipe coupled together diameter inches. Elevation of ground at well site 380 feet, mean sea level.
(As near as known)

Depth to water table 12 feet.

7. Capacity of Well: g.p.m. with feet drawdown.

g.p.m. with feet drawdown.

Date of test not tested

If Flowing Well: Measured discharge g.p.m. on
(Date)

Shut-in pressure at ground surface lbs. per sq. in. on
(Date)

Water is controlled by
(Cap, valve, etc.)

8. Casing: (Give diameter, commercial specifications and depth below ground surface of each casing size.)

..... inch diameter from to feet
 inch diameter from to feet
 inch diameter from to feet
 inch diameter from to feet

Describe and show depth of shoe, plug, adapter, liner or other details:

.....

9. Perforated Casings or Screens:

..... slotted 1/2" x 5/8" : 6 per ft from ^{23 1/2} 17 to 271
 (Number per foot and size of perforations, or describe screen)
 from to
 from to
 from to

10. Log of Well: (Describe each stratum or formation clearly, indicate if water bearing, and give thickness and depth as indicated.)

MATERIAL	Thickness (Feet)	Depth to Bottom (Feet)

If log of well is not available, give name and address of driller.

11. Infiltration Trench: Covered or open

Dimensions: Length ft. Minimum depth ft. Maximum depth ft.

Bottom width ft. Discharge g.p.m. Date of test

12. Tunnel: Type of lining

Dimensions: (Length, course, and optional size)

Position of water bearing stratum with reference to portal tunnel

Log of tunnel: (Preceding table for log of well may be used, if desired. Give footage from portal and character of materials, as pertinent.)

13. Pumping Equipment:

(a) Pump Fairbanks Morse Cent. 4" x 3 1/2" Capacity 260 g.p.m.
(Make, type and size)

(b) Motor 10 hp electric 3 phase
(Type and horsepower)


14. Location of area irrigated or to be irrigated, or place of use if for purposes other than irrigation.

Township North or South	Range E. or W. of Willamette Meridian	Section	Forty-acre Tract	Number Acres To Be Irrigated	Date of Reclamation
T17 S	3 W	5	NE 1/4 NE 1/4	23.42	1951

15. If the ground water supply is supplemental to an existing water supply, identification of any application for a permit, permit, certificate or adjudicated right to appropriate water made or held by the registrant.

SEE ATTACHED MAP

Township 17 S Range 3 W W.M.
North

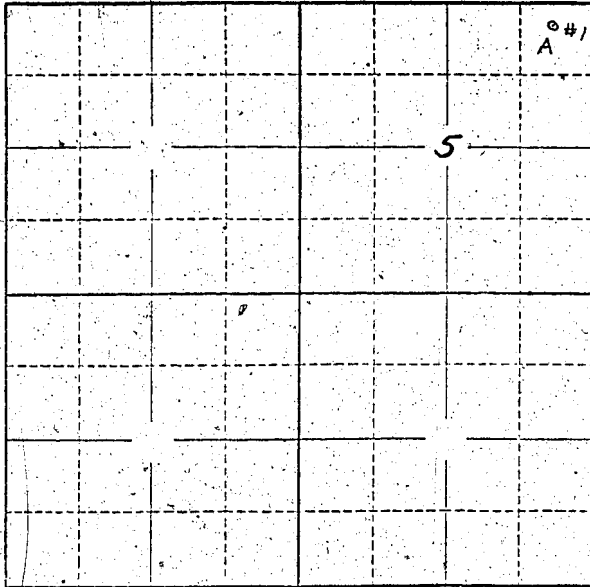

Locate well and acreage of irrigated land on plat.
Scale: 2" = 1 Mile

STATE OF OREGON

County of _____ Lane } ss.

I, Leon H. Funke and/or Flossie Funke, being first duly sworn, do hereby certify that I have read the foregoing Registration Statement and that all of the items therein contained are true to the best of my knowledge and belief.

Leon H. Funke and/or Flossie Funke
(Signature of Registrant)

Subscribed and sworn to before me this 29th day of July, 1958

My commission expires May 14, 1961
(Notary Public)

(SEAL)

CERTIFICATE OF REGISTRATION

STATE OF OREGON } ss.
County of Marion

This is to certify that the foregoing Registration Statement was received in the office of the State Engineer on the 30th day of July, 1958, at 9:22 o'clock A.M. and has been duly recorded in said office in Book No. 13 of Registration Statements on page GR-3005

Witness my hand this 2nd day of June, 1959

Lewis A. Stanley
(State Engineer)

By _____ (Deputy)

GR - 3005

#15.00