

RECEIVED
STATE ENGINEER
SALES OREGON
8am

REGISTRATION NO. GR-323
CERTIFICATE NO. GR-305

Registration Statement

CLAIMANT OF RIGHT TO APPROPRIATE GROUND WATER

(Under Chapter 708, Oregon Laws 1955.)

TO THE STATE ENGINEER OF OREGON:

I, Town of Sublimity

of Marion County of _____

State of Oregon, do hereby make application for a certificate of registration as evidence of a right to appropriate ground water.

1. Source from which water is withdrawn is Pump well
(Flowing well, pump well, infiltration trench, or tunnel)

2. Location is: within city limits
(Approximate distance and direction from nearest city or town)

and is more particularly described as follows:

(a) 21.45 chains north and 22.7 chains west from S.E. corner of section 34
(Give distance and bearing to corner of section or other legal subdivision)

being within NW 1/4 8E 4 of Sec. 34, Twp. 8 S. Rge. 1 W.
(Smallest legal subdivision) (N. or S.) (E. or W.)

or (b) within limits of recorded platted property, town or city: _____

in Lot 1, Block 21 of Main Town
(Name of plat or addition)

Sublimity County of Marion
(If within city or town, give name)

3. Construction Work was begun on Mar. 1, 1948; was completed on Mar 30, 1948
(Date) (Date)

and the ground water claimed was first used for the purposes set out below on 1948
(Date)

since which time the water has been used continuously
(Continuously or intermittently)

from April, 1948 to Jan, 1957
(Date) (Date)

4. Quantity of water claimed and used is 90 gallons per minute; 95 acre feet per year.

5. Purpose or Purposes for which water is used municipal

(Domestic, irrigation, municipal, manufacturing, industrial, etc.)

6. Description of Well: Depth 370 feet. Type drilled
(Dug or drilled)

diameter 12 inches. Elevation of ground at well site 480 550 feet, mean sea level.
(As near as known)

Depth to water table 68 feet.

7. Capacity of Well: 90 g.p.m. with 7 feet drawdown.

_____ g.p.m. with _____ feet drawdown.

Date of test before we pump

If Flowing Well: Measured discharge _____ g.p.m. on _____
(Date)

Shut-in pressure at ground surface _____ lbs. per sq. in. on _____
(Date)

Water is controlled by _____
(Cap, valve, etc.)

8. Casing: (Give diameter, commercial specifications and depth below ground surface of each casing size.)

8 inch diameter from 0 to 210 feet
solid rock beyond
 inch diameter from 210 to 270 feet
 inch diameter from to feet
 inch diameter from to feet

Describe and show depth of shoe, plug, adapter, liner or other details:

9. Perforated Casings or Screens:

unknown from to
 (Number per foot and size of perforations, or describe screen)
 from to
 from to
 from to

10. Log of Well: (Describe each stratum or formation clearly, indicate if water bearing, and give thickness and depth as indicated.)

MATERIAL	Thickness (Feet)	Depth to Bottom (Feet)
<i>attached</i>		
soil, top and clay, red	21	21
clay, yellow	29	50
clay, blue	10	60
clay, yellow	30	90
clay, with scattered rock (basalt)	20	110
clay, yellow	8	118
clay, blue	7	125
clay, grey	15	140
clay, red - scattered gravel (contact)	18	158
clay, brown	12	170
conglomerate	18	198
rock, grey	14	212
rock, black	20	232
" " lava	32	264
rock, gray	6	270
clay, blue & brown	9	279
rock, black porous	15	294
rock, black	53	347
rock, black hard	9	356
rock, black	14	370

GR-305 A

If log of well is not available, give name and address of driller:

11. Infiltration Trench: Covered or open

Dimensions: Length ft. Minimum depth ft. Maximum depth ft.
 Bottom width ft. Discharge g.p.m. Date of test

12. Tunnel: Type of lining

Dimensions:
(Length, course, and cross sectional size)
 Position of water bearing stratum with reference to portal of tunnel

Log of tunnel: (Preceding table for log of well may be used, if desired. Give footage from portal and character of materials, as pertinent.)

13. Pumping Equipment:


(a) Pump Fairbank Morris Turbine Capacity 90 g.p.m.
(Make, type and size)
 (b) Motor 7 1/2 H.P. Fairbank Morris
(Type and horsepower)

14. Location of area irrigated or to be irrigated, or place of use if for purposes other than irrigation.

Township North or South	Range E or W. of Willamette Meridian	Section	Forty-acre Tract	Number Acres To Be Irrigated	Date of Reclamation
T8S	1W	34	<i>SE 1/4 of NW 1/4</i>	<i>Municipal use</i>	
		34	<i>SW 1/4 of NE 1/4</i>		
		34	<i>SE 1/4 of NE 1/4</i>		
		34	<i>all of SE 1/4</i>		
		34	<i>E 1/2 of SW 1/4</i>		
		35	<i>SW 1/4 of NW 1/4</i>		
		35	<i>W 1/2 of SW 1/4</i>		

15. If the ground water supply is supplemental to an existing water supply, identification of any application for a permit, permit, certificate or adjudicated right to appropriate water made or held by the registrant.

North

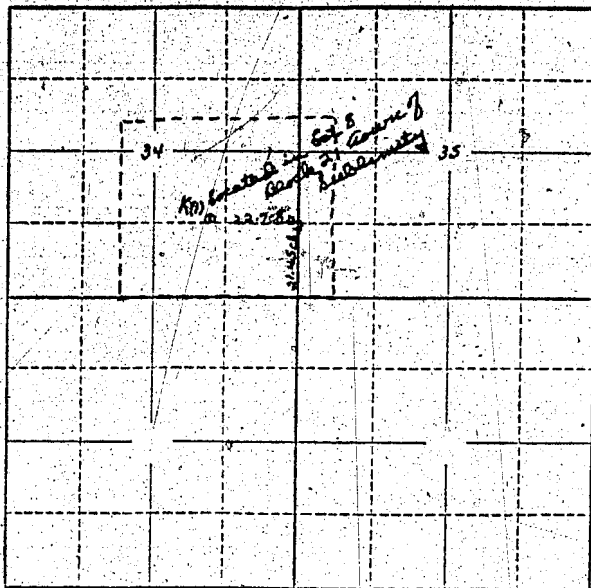

Locate well and acreage of irrigated land on plat.
Scale: 2" = 1 Mile

STATE OF OREGON

County of Marion } ss.

I, J. R. Bradley, Recorder, being first duly sworn, do hereby certify that I have read the foregoing Registration Statement and that all of the items therein contained are true to the best of my knowledge and belief.

J. R. Bradley Recorder
(Signature of Registrant)

Subscribed and sworn to before me this 2 day of Jan, 1957.

My commission expires 5/21/58 George H. Bass
(Notary Public)

(SEAL)

CERTIFICATE OF REGISTRATION

STATE OF OREGON } ss.
County of Marion

This is to certify that the foregoing Registration Statement was received in the office of the State Engineer on the 2nd day of January, 1957, at 8 o'clock A. M. and has been duly recorded in said office in Book No. 2 of Registration Statements on page GR-305 C.

~~Construction has been completed by~~ ~~xxxxxxx-18xx-~~ ~~and the water completely applied to~~ ~~the field by~~ ~~xxxxxxx-18xx-~~

Witness my hand this 4th day of March, 1957.

Lewis A. Stanley
(State Engineer)

By _____
(Deputy)

GR-305 C

20⁰²