

Registration Statement**OF CLAIMANT OF RIGHT TO APPROPRIATE GROUND WATER****TO THE STATE ENGINEER OF OREGON:**

I, J. E. Thomas
 of Rt. 1, Box 285, Albany County of Linn
(Mailing address)
 State of Oregon do hereby make application for a certificate of registration as evidence
 of a right to appropriate ground water.

1. Source from which water is withdrawn is pump well
(Flowing well, pump well, infiltration trench, or tunnel)

2. Location is: 6 miles E. of Albany, Oregon
(Approximate distance and direction from nearest city or town)

and is more particularly described as follows:

(a) 660' S. and 1715' E. of NW corner of S. 9, T. 11 S, R. 2W.
(Give distance and bearing to corner of section or other legal subdivision)

being within NE¹ of NW¹ of Sec. 9, Twp. 11 S, Rge. 2 W
(Smallest legal subdivision) (N. or S.) (E. or W.)

or (b) within limits of recorded platted property, town or city:

in Lot _____, Block _____ of _____
(Name of plat or addition)

County of Linn
(If within city or town, give name)

3. Construction Work was begun on July 15, 1949; was completed on July 15, 1949
(Date) (Date)

and the ground water claimed was first used for the purposes set out below on July 15, 1949
(Date)

since which time the water has been used continuously
(Continuously or intermittently)

from July 15, 1949 to present time
(Date) (Date)

4. Quantity of water claimed and used is 250 gallons per minute; 86.4 acre
 feet per year.

5. Purpose or Purposes for which water is used Irrigation

(Domestic, irrigation, municipal, manufacturing, industrial, etc.)

6. Description of Well: Depth 20¹ feet. Type Drilled
(Dug or drilled)

diameter 10 inches. Elevation of ground at well site 260 feet, mean sea level.
(As near as known)

Depth to water table 9 feet.

7. Capacity of Well: 600 g.p.m. with 8 feet drawdown.

 g.p.m. with feet drawdown.

Date of test July 15, 1949

If Flowing Well: Measured discharge g.p.m. on
(Date)

Shut-in pressure at ground surface lbs. per sq. in. on
(Date)

Water is controlled by
(Cap, valve, etc.)

size.

10	inch diameter	steel casing	from	0	to	201	feet
	inch diameter		from		to		feet
	inch diameter		from		to		feet
	inch diameter		from		to		feet

Describe and show depth of shoe, plug, adapter, liner or other details:

9. Perforated Casings or Screens:


Slot perforations (Number per foot and size of perforations, or describe screen)	from	to
	11	20 $\frac{1}{2}$

10. **Log of Well:** (Describe each stratum or formation clearly, indicate if water bearing, and give thickness and depth as indicated.)

[illegible]

GR 3015

Township 11 S Range 2 W W.M.
North

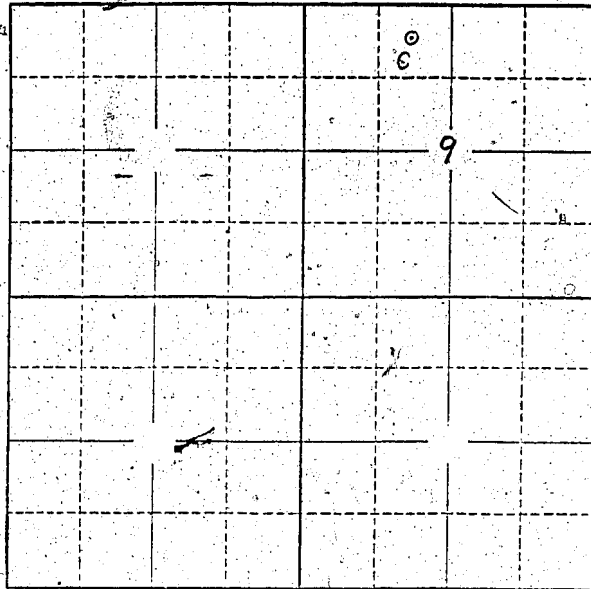

Locate well and acreage of irrigated land on plat.

Scale: 2" = 1 Mile

STATE OF OREGON

County of LINN

ss.

I, J. E. Thomas, being first duly sworn, do hereby certify that I have read the foregoing Registration Statement and that all of the items therein contained are true to the best of my knowledge and belief.

(Signature of Registrant)

Subscribed and sworn to before me this 25 day of July, 19 58.

My commission expires June 9, 1960

(Notary Public)

(SEAL)

CERTIFICATE OF REGISTRATION

STATE OF OREGON

County of Marion

ss.

This is to certify that the foregoing Registration Statement was received in the office of the State Engineer on the 30 day of July, 19 58, at 8:00 o'clock A. M. and has been duly recorded in said office in Book No. 13 of Registration Statements on page GR-3015.

Witness my hand this 8th day of June, 19 59.

(State Engineer)

By

(Deputy)

GR-3015