

# Registration Statement

## OF CLAIMANT OF RIGHT TO APPROPRIATE GROUND WATER

### TO THE STATE ENGINEER OF OREGON:

I, C. O. or Grace Pape

of Rt. 3, Box 92, Lebanon  
(Mailing address)

County of Linn

State of Oregon do hereby make application for a certificate of registration as evidence of a right to appropriate ground water.

1. Source from which water is withdrawn is pump well

(Flowing well, pump well, infiltration trench, or tunnel)

2. Location is: 9 miles N. of Lebanon, Oregon

(Approximate distance and direction from nearest city or town)

and is more particularly described as follows:

(a) 1716' N., 825' E. of SW corner Sec. 11, Tp. 11 S., R. 2 W.

(Give distance and bearing to corner of section or other legal subdivision)

being within NW 1/4 of SW 1/4

(Smallest legal subdivision)

of Sec. 11

Twp. 11 S.

(N. or S.)

Rge. 2 W.

(E. or W.)

or (b) within limits of recorded platted property, town or city:

in Lot \_\_\_\_\_, Block \_\_\_\_\_ of \_\_\_\_\_

(Name of plat or addition)

County of Linn

(If within city or town, give name)

3. Construction Work was begun on 1940; was completed on 1940

(Date)

(Date)

and the ground water claimed was first used for the purposes set out below on 1940

(Date)

since which time the water has been used intermittently

(Continuously or intermittently)

from 1940 to present time

(Date)

(Date)

4. Quantity of water claimed and used is 150 gallons per minute; 78.0 acre feet per year.

5. Purpose or Purposes for which water is used Irrigation

(Domestic, irrigation, municipal, manufacturing, industrial, etc.)

6. Description of Well: Depth 37 feet. Type Drilled

(Dug or drilled)

diameter 8 inches. Elevation of ground at well site 260 feet, mean sea level.

(As near as known)

Depth to water table 12 feet.

7. Capacity of Well: \_\_\_\_\_ g.p.m. with \_\_\_\_\_ feet drawdown.

\_\_\_\_\_ g.p.m. with \_\_\_\_\_ feet drawdown.

Date of test Not tested

If Flowing Well: Measured discharge \_\_\_\_\_ g.p.m. on \_\_\_\_\_

(Date)

Shut-in pressure at ground surface \_\_\_\_\_ lbs. per sq. in. on \_\_\_\_\_

(Date)


Water is controlled by \_\_\_\_\_

(Cap. valve, etc.)





Township 11 S Range 2 W W.M.  
North

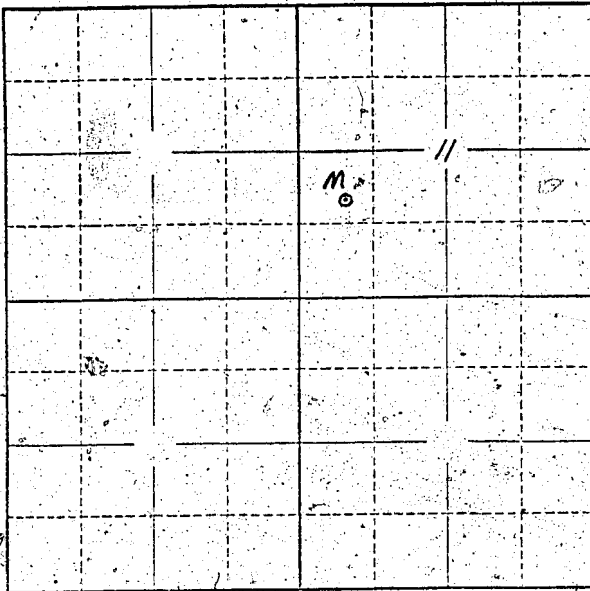

Locate well and acreage of irrigated land on plat.

Scale: 2" = 1 Mile

STATE OF OREGON

County of LINN

ss.

I, C. O. and Grace Pape, being first duly sworn, do hereby certify that I have read the foregoing Registration Statement and that all of the items therein contained are true to the best of my knowledge and belief.

*C. O. Pape*  
*Grace Pape*  
(Signature of Registrant)

Subscribed and sworn to before me this 29 day of July, 1959

My commission expires MY COMMISSION EXPIRES MAY 22, 1962

*William E. Pugh*  
(Notary Public)

(SEAL)

CERTIFICATE OF REGISTRATION

STATE OF OREGON

County of Marion

ss.

This is to certify that the foregoing Registration Statement was received in the office of the State Engineer on the 30 day of July, 1959, at 11 o'clock A.M. and has been duly recorded in said office in Book No. 13 of Registration Statements on page GR-3016

Witness my hand this 8th day of June, 1959

*Anna A. Stanley*  
(State Engineer)

By \_\_\_\_\_ (Deputy)

#15.00

GR - 3016