

Registration Statement

OF CLAIMANT OF RIGHT TO APPROPRIATE GROUND WATER

TO THE STATE ENGINEER OF OREGON:

I, A. R. & D. W. Shaffner aka Shaffner Brothers
of 211 River Avenue Eugene, Oregon County of Lane
(Mailing address)

State of Oregon do hereby make application for a certificate of registration as evidence of a right to appropriate ground water.

1. Source from which water is withdrawn is Pumpwell # 2
(Flowing well, pump well, infiltration trench, or tunnel)

2. Location is 3-1/2 mi. North of Eugene, Oregon
(Approximate distance and direction from nearest city or town)

and is more particularly described as follows:

(a) S61°45'E 1240' from NW Corner of Section 13
(Give distance and bearing to corner of section or other legal subdivision)
being within NW of NW of Sec. 13, Twp. 17S, Rge. 4W
(Smallest legal subdivision) (N. or S.) (E. or W.)

or (b) within limits of recorded platted property, town or city:

in Lot _____, Block _____ of _____
(Name of plat or addition)

County of _____
(If within city or town, give name)

3. Construction Work was begun on March 1936; was completed on March 1936
(Date) (Date)

and the ground water claimed was first used for the purposes set out below on March 1936
(Date)

since which time the water has been used Intermittently
(Continuously or Intermittently)

from March to August
(Date) (Date)

4. Quantity of water claimed and used is 300 gallons per minute; _____ acre feet per year.

5. Purpose or Purposes for which water is used Irrigation

(Domestic, irrigation, municipal, manufacturing, industrial, etc.)

6. Description of Well: Depth 24 feet. Type Driven
(Dug or drilled)

diameter 4" inches. Elevation of ground at well site 390 feet, mean sea level.
(As near as known)

Depth to water table 12 feet.

7. Capacity of Well: 300 g.p.m. with _____ feet drawdown.

_____ g.p.m. with _____ feet drawdown.


Date of test March/1936

If Flowing Well: Measured discharge _____ g.p.m. on _____
(Date)

Shut-in pressure at ground surface _____ lbs. per sq. in. on _____
(Date)

Water is controlled by _____
(Cap, valve, etc.)

Township 17S Range 4W, W.M.
North

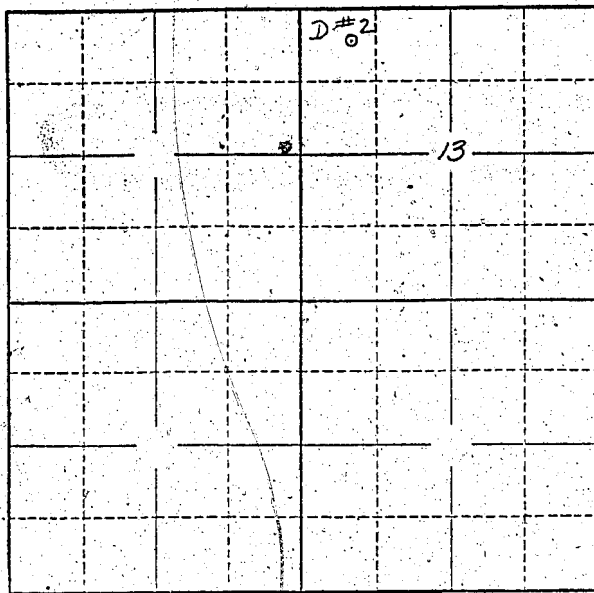

Locate well and acreage of irrigated land on plat.
Scale: 2" = 1 Mile

STATE OF OREGON }
County of Lane } ss.

I, Donald W. Shaffner, being first duly sworn, do hereby certify that I have read the foregoing Registration Statement and that all of the items therein contained are true to the best of my knowledge and belief.

.....
(Signature of Registrant)

Subscribed and sworn to before me this 29th day of July, 1958

My commission expires 3-3-61

Mary J. Stuart
(Notary Public)

(SEAL)

CERTIFICATE OF REGISTRATION

STATE OF OREGON }
County of Marion } ss.

This is to certify that the foregoing Registration Statement was received in the office of the State Engineer on the 29th day of July, 1958, at 7 o'clock A. M. and has been duly recorded in said office in Book No. 13 of Registration Statements on page GR-3020

Witness my hand this 8th day of June, 1959

\$15.00

Lewis A. Stanley
(State Engineer)

By
(Deputy)