

Registration Statement

OF CLAIMANT OF RIGHT TO APPROPRIATE GROUND WATER

TO THE STATE ENGINEER OF OREGON:

I, ALBERT FUNKNER
 of RT. 2 Box 238 BORING County of CLACKAMAS
(Mailing address)

State of OREGON, do hereby make application for a certificate of registration as evidence of a right to appropriate ground water.

1. Source from which water is withdrawn is PUMP WELL
(Flowing well, pump well, infiltration trench, or tunnel)

2. Location is: 1 mi. NORTH - BORING ORE
(Approximate distance and direction from nearest city or town)

and is more particularly described as follows:

(a) D 1600 ft. N.W. from the SE corner of NE 1/4
(Give distance and bearing to corner of section or other legal subdivision)
 being within SW 1/4 of NE 1/4 of Sec. 36, Twp. 1 S, Rge. 3 E
(Smallest legal subdivision) (S. or N.) (E. or W.)

or (b) within limits of recorded platted property, town or city:

in Lot _____, Block _____ of _____
(Name of plat or addition)

County of _____
(If within city or town, give name)

3. Construction Work was begun on SUMMER 1946; was completed on SUMMER 1946
(Date) (Date)

and the ground water claimed was first used for the purposes set out below on JAN 17, 1958
(Date)

since which time the water has been used CONTINUOUSLY
(Continuously or intermittently)

from JAN 17, 1958 to PRESENT
(Date) (Date)

4. Quantity of water claimed and used is 20 gallons per minute; _____ acre feet per year.

5. Purpose or Purposes for which water is used IRRIGATION & DOMESTIC

(Domestic, irrigation, municipal, manufacturing, industrial, etc.)

6. Description of Well: Depth 150 feet. Type DRILLED
(Dug or drilled)

diameter 8 inches. Elevation of ground at well site 500 feet, mean sea level.
(As near as known)

Depth to water table 60 feet.

7. Capacity of Well: 100 g.p.m. with _____ feet drawdown.

_____ g.p.m. with _____ feet drawdown.

Date of test 1946

If Flowing Well: Measured discharge _____ g.p.m. on _____
(Date)

Shut-in pressure at ground surface _____ lbs. per sq. in. on _____
(Date)

Water is controlled by _____
(Cap, valve, etc.)

8. **Casing:** (Give diameter, commercial specifications and depth below ground surface of each casing size.)

..... 8 inch diameter from 0 to feet
 inch diameter from to feet
 inch diameter from to feet
 inch diameter from to feet

Describe and show depth of shoe, plug, adapter, liner or other details: _____

9. Perforated Casings or Screens:

(Number per foot and size of perforations, or describe screen) ~~24~~ from to

from to

from to

from to

10. **Log of Well:** (Describe each stratum or formation clearly, indicate if water bearing, and give thickness and depth as indicated.)

[illegible]

If log of well is not available, give name and address of driller. H. BOTTNER
11544 N.E. GLISON ST. PORTLAND, ORE.

Dimensions: Length ft. Minimum depth ft. Maximum depth ft.

12. Tunnel: Type of lining

Position of water bearing stratum with reference to portal of tunnel

13. Pumping Equipment:

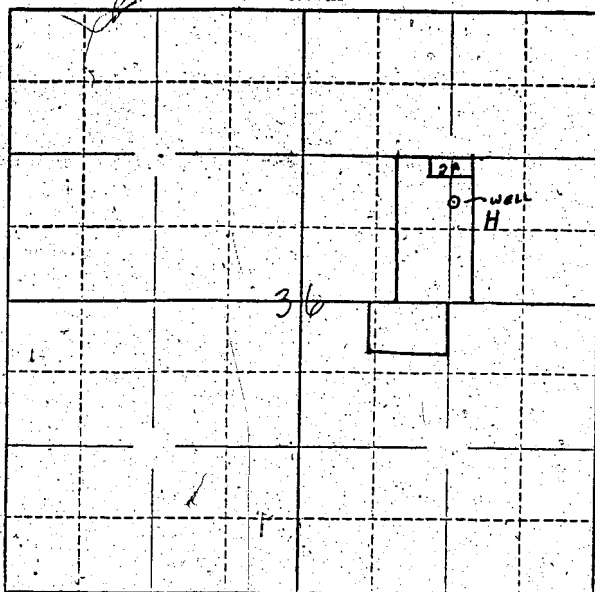
(b) Motor ELECTRIC - 1 1/2 HP
(Type and horsepower)

[illegible]

GR 3025

Township 15 Range 3E W.M. SECT 36

North



Locate well and acreage of irrigated land on plat.

Scale:  = 1 Mile

4"

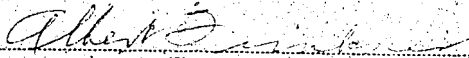
STATE OF OREGON

County of

CLACKAMAS

ss.

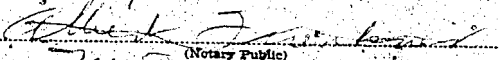
I, ALBERT FINKNEIR, being first duly sworn, do hereby certify that I have read the foregoing Registration Statement and that all of the items therein contained are true to the best of my knowledge and belief.


(Signature of Registrant)

Subscribed and sworn to before me this 29th day of July, 1958.

My commission expires

My Comm. Exp. April 19, 1961


(Notary Public)

(SEAL)

CERTIFICATE OF REGISTRATION

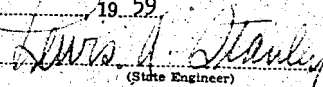
STATE OF OREGON

County of Marion

ss.

This is to certify that the foregoing Registration Statement was received in the office of the State Engineer on the 30 day of July, 1958, at 5:00 o'clock A. M. and has been duly recorded in said office in Book No. 13 of Registration Statements on page GR-3025

Witness my hand this 8th day of June, 1959.


(State Engineer)

By

(Deputy)

GR - 3025