

Registration Statement

OF CLAIMANT OF RIGHT TO APPROPRIATE GROUND WATER

TO THE STATE ENGINEER OF OREGON:

I, Gerald B. Gray

of P. O. Box 5197, Aloha County of Washington

State of Oregon, do hereby make application for a certificate of registration as evidence of a right to appropriate ground water.

1. Source from which water is withdrawn is Pump well
(Flowing well, pump well, infiltration trench, or tunnel)

2. Location is: two and one-half miles west of Beaverton, Ore
(Approximate distance and direction from nearest city or town)

and is more particularly described as follows:

(a) 380 feet west and 30 feet north of 1/4 corner on South line Section 7,
(Give distance and bearing to corner of section or other legal subdivision)
being within SE 1/4 of SW 1/4 of NE 1/4 of Sec. 18 Twp. 1 S Rge. 1 W
(Smallest legal subdivision) (N. or S.) (E. or W.)

or (b) within limits of recorded platted property, town or city:

in Lot 276, Block _____ of Johnson Estate Addition to Beaverton-Reedville
(Name of plat or addition)
County of Washington
(If within city or town, give name)

3. Construction Work was begun on May 1946; was completed on May 1946

and the ground water claimed was first used for the purposes set out below on June 1, 1946

since which time the water has been used continuously

from 6/1/1946 to present date

4. Quantity of water claimed and used is 10 gallons per minute; _____ acre feet per year sufficient to irrigate lawn, shrubs, etc; less than capacity of pump during irrigating season.

5. Purpose or Purposes for which water is used Irrigation of lawn, shrubs and trees on the North one acre of Lot 276, Johnson Estate Addition to BRA
(Domestic, irrigation, municipal, manufacturing, industrial, etc.)

6. Description of Well: Depth 108 feet. Type Drilled

diameter 6 inches. Elevation of ground at well site 200 feet, mean sea level.
(As near as known)

Depth to water table 18 feet, as per measurement in 1946 at time pumping equipment installed.

7. Capacity of Well: _____ g.p.m. with _____ feet drawdown.
_____ g.p.m. with _____ feet drawdown.

Date of test No test ever made.

If Flowing Well: Measured discharge _____ g.p.m. on _____
(Date)

Shut-in pressure at ground surface _____ lbs. per sq. in. on _____
(Date)

Water is controlled by _____
(Cap, valve, etc.)

8. Casing: (Give diameter, commercial specifications and depth below ground surface of each casing size.)

6" inch diameter Standard T. & C. from 0 to 91 feet
 inch diameter from to feet
 inch diameter from to feet
 inch diameter from to feet

Describe and show depth of shoe, plug, adapter, liner or other details:

89 feet to top of liner

9. Perforated Casings or Screens:

5" perforated liner from 89 to 102 ft.
(Number per foot and size of perforations, or describe screen)
 from to
 from to
 from to

10. Log of Well: (Describe each stratum or formation clearly, indicate if water bearing, and give thickness and depth as indicated.)

MATERIAL	Thickness (Feet)	Depth to Bottom (Feet)
Note: No log made, per driller		

If log of well is not available, give name and address of driller: Paul E. Ross, 2040 S. W.

192nd Ave., Aloha, Oregon

11. Infiltration Trench: Covered or open
 Dimensions: Length ft. Minimum depth ft. Maximum depth ft.

Bottom width ft. Discharge g.p.m. Date of test

12. Tunnel: Type of lining

Dimensions:
(Length, course, and cross sectional size)

Position of water bearing stratum with reference to portal of tunnel

Log of tunnel: (Preceding table for log of well may be used, if desired. Give footage from portal and character of materials, as pertinent.)

13. Pumping Equipment:

(a) Pump Meyers Ejecto Capacity 10 g.p.m.
(Make, type and size)

(b) Motor One-horse General Electric Westinghouse
(Type and horsepower)

14. Location of area irrigated or to be irrigated, or place of use if for purposes other than irrigation.


Township North or South	Range E. or W. of Willamette Meridian	Section	Forty-acre Tract	Number Acres To Be Irrigated	Date of Reclamation
1 S	1 W	7	SE $\frac{1}{4}$ of SW $\frac{1}{4}$	Approx 3/4	4/1/1946
1 S	1 W	18	NE $\frac{1}{4}$ of NW $\frac{1}{4}$	Approx $\frac{1}{2}$ <u>1.0</u>	4/1/1946

15. If the ground water supply is supplemental to an existing water supply, identification of any application for a permit, permit, certificate or adjudicated right to appropriate water made or held by the registrant.

Have no other permit or water right. Use Aloha-Huber Water

District water in house.

Township 1 S Range 1 W, W.M.
North

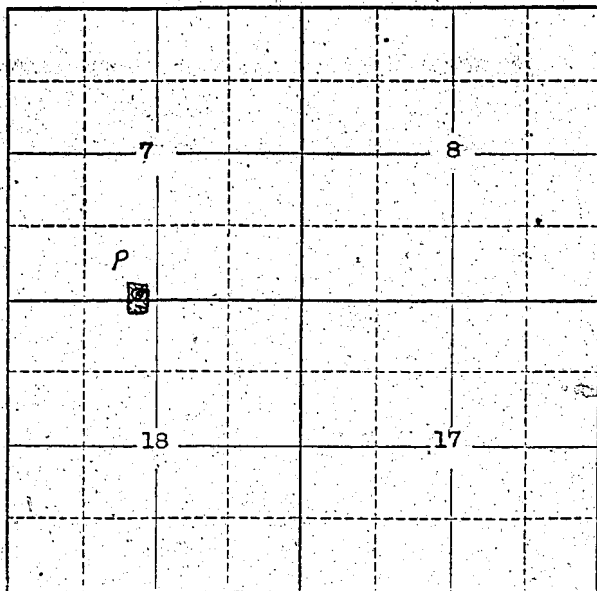

See Additional sketch attached

Locate well and acreage of irrigated land on plat.
Scale: 2" = 1 Mile

STATE OF OREGON

County of Washington } ss.

I, Gerald E. Gray, being first duly sworn, do hereby certify that I have read the foregoing Registration Statement and that all of the items therein contained are true to the best of my knowledge and belief.

Gerald E. Gray

(Signature of Registrant)

Subscribed and sworn to before me this 15th day of July, 1958

My commission expires 7-10-59

Paul K. von Bergau
(Notary Public)

(SEAL)

CERTIFICATE OF REGISTRATION

STATE OF OREGON

County of Marion } ss.

This is to certify that the foregoing Registration Statement was received in the office of the State Engineer on the 30th day of July, 1958, at 8:00 o'clock A.M. and has been duly recorded in said office in Book No. 13 of Registration Statements on page GR-3026.

Witness my hand this 8th day of June, 1959

Stewart A. Stanley

(State Engineer)

\$15.00

By _____
(Deputy)