

Registration Statement

OF CLAIMANT OF RIGHT TO APPROPRIATE GROUND WATER

TO THE STATE ENGINEER OF OREGON:

I, Delta Culp
 of Dayton Oreg. Route 1 County of Yamhill
(Mailing address)
 State of Oregon, do hereby make application for a certificate of registration as evidence of a right to appropriate ground water.

1. Source from which water is withdrawn is Pump well
(Flowing well, pump well, infiltration trench, or tunnel)

2. Location is: 9 miles south of Dayton
(Approximate distance and direction from nearest city or town)

and is more particularly described as follows:

(a) N 40° 21' W 1132.4 ft. From E 1/4 corner of sec. 23
(Give distance and bearing to corner of section or other legal subdivision)

being within S.E. N.E. of Sec. 23, Twp. 5 N., Rge. 3 W
(Smallest legal subdivision) (N. or S.) (E. or W.)

or (b) within limits of recorded plat ~~property~~, town or city:

in Lot _____ Block _____ of _____
(Name of plat or addition)

County of _____
(If within city or town, give name)

3. Construction Work was begun on 1940; was completed on 1940
(Date) (Date)

and the ground water claimed was first used for the purposes set out below on 1940
(Date)

since which time the water has been used intermittently during season
(Continuously or intermittently)
 from May 1st to Sept. 1st
(Date) (Date)

4. Quantity of water claimed and used is 320 gallons per minute; ~~acre~~ acre feet per year.

5. Purpose or Purposes for which water is used irrigation

(Domestic, irrigation, municipal, manufacturing, industrial, etc.)

6. Description of Well: Depth 25 feet. Type Driven
(Dug or drilled)

diameter 8 in. x 4 in. 2 ft apart Elevation of ground at well site _____ feet, near sea level.
(As near as known)

Depth to water table 12 feet.

7. Capacity of Well: _____ g.p.m. with 10 feet drawdown.

_____ g.p.m. with _____ feet drawdown.


Date of test _____

If Flowing Well: Measured discharge _____ g.p.m. on _____
(Date)

Shut-in pressure at ground surface _____ lbs. per sq. in. on _____
(Date)

Water is controlled by _____
(Cap, valve, etc.)

Township 5 8 Range 3 W W.M.
North

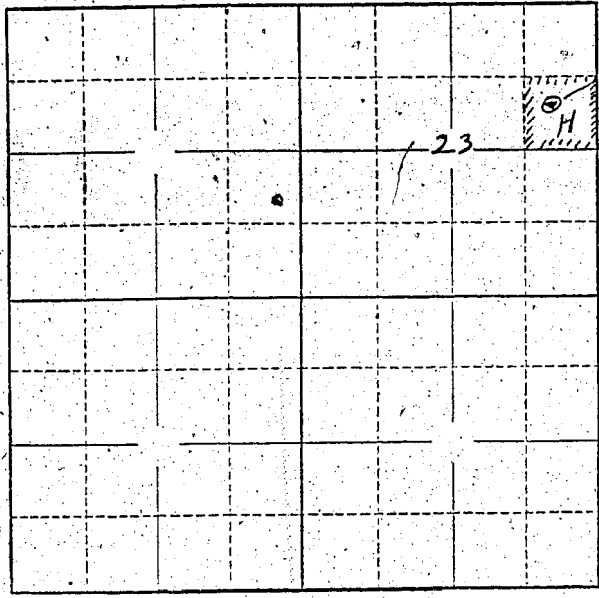

Locate well and acreage of irrigated land on plat.
Scale: 2" = 1 Mile

STATE OF OREGON

County of Marion } ss.

I, Delta Culp, being first duly sworn, do hereby certify that I have read the foregoing Registration Statement and that all of the items therein contained are true to the best of my knowledge and belief.

Delta Culp
(Signature of Registrant)

Subscribed and sworn to before me this 30th day of July, 1958

My commission expires 12th June 1961 Wm. S. Bartholomew
(Notary Public)

(SEAL)

CERTIFICATE OF REGISTRATION

STATE OF OREGON

County of Marion } ss.

This is to certify that the foregoing Registration Statement was received in the office of the State Engineer on the 30th day of July, 1958, at 2:15 o'clock P. M. and has been duly recorded in said office in Book No. 13 of Registration Statements on page GR-3029.

Witness my hand this 8th day of June, 1959

Lewis A. Sturley
(State Engineer)

By _____ (Deputy)

\$ 16.50