

Registration Statement

OF CLAIMANT OF RIGHT TO APPROPRIATE GROUND WATER

TO THE STATE ENGINEER OF OREGON:

I, Billy J. Towery
of Route 1, Box 379 Salem County of Polk
(Mailing address)
State of Oregon, do hereby make application for a certificate of registration as evidence of a right to appropriate ground water.

1. Source from which water is withdrawn is: pump well
(Flowing well, pump well, infiltration trench, or tunnel)
2. Location is: 3 mi North of W. Salem
(Approximate distance and direction from nearest city or town)

and is more particularly described as follows:

(a) 1070 East of the N.W. Corner of Sec 9 T7S R3W
(Give distance and bearing to corner of section or other legal subdivision)
being within NW 1/4 of NW 1/4 of Sec. 9, Twp. 7 S, Rge. 3 W
(Smallest legal subdivision) (N. or S.) (E. or W.)

or (b) within limits of recorded platted property, town or city:

in Lot _____, Block _____ of _____
(Name of plat or addition)

County of Polk
(If within city or town, give name)

3. Construction Work was begun on May 1955; was completed on May 1955
(Date) (Date)
and the ground water claimed was first used for the purposes set out below on June 1955
(Date)
since which time the water has been used continuously throughout the growing season
(Continuously or intermittently)
from Spring to Fall
(Date) (Date)

4. Quantity of water claimed and used is 500 gallons per minute; 88.25 acre feet per year.

5. Purpose or Purposes for which water is used irrigation

(Domestic, irrigation, municipal, manufacturing, industrial, etc.)
6. Description of Well: Depth 33 feet. Type drilled
(Dug or drilled)
diameter 8 inches. Elevation of ground at well site 145 feet, mean sea level.
(As near as known)
Depth to water table 12 feet.

7. Capacity of Well: 500 g.p.m. with 6 feet drawdown.
_____ g.p.m. with _____ feet drawdown.


Date of test May 1955

If Flowing Well: Measured discharge _____ g.p.m. on _____
(Date)

Shut-in pressure at ground surface _____ lbs. per sq. in. on _____
(Date)

Water is controlled by _____
(Cap, valve, etc.)

Township 7S Range 3W, W.M.
North

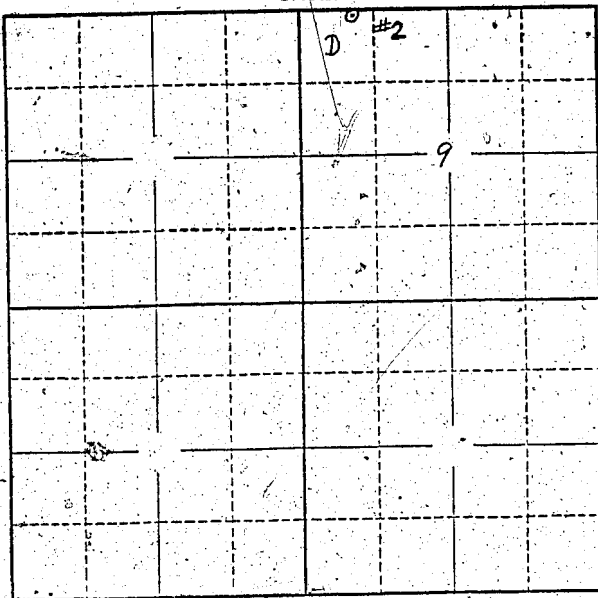

Locate well and acreage of irrigated land on plat.
Scale: 2" = 1 Mile

STATE OF OREGON


I, Billy J. Towery being first duly sworn, do hereby certify that I have read the foregoing Registration Statement and that all of the items therein contained are true to the best of my knowledge and belief.

Billy J. Towery
(Signature of Registrant)

Subscribed and sworn to before me this 21st day of February, 1958

My commission expires July 16, 1961 - Arthur G. Hart
(Notary Public)

(SEAL)

CERTIFICATE OF REGISTRATION

STATE OF OREGON

County of Marion } ss.

This is to certify that the foregoing Registration Statement was received in the office of the State Engineer on the 31st day of July, 1958, at 2⁰⁰ o'clock P. M. and has been duly recorded in said office in Book No. 13 of Registration Statements on page GR-3031

Witness my hand this 8th day of June, 1959

Laura A. Stanley
(State Engineer)

By _____ (Deputy)

\$15.90