

# Registration Statement

## OF CLAIMANT OF RIGHT TO APPROPRIATE GROUND WATER

TO THE STATE ENGINEER OF OREGON:

I, Frank Henry  
of Rt 1 Box 160 Brooks County of Marion  
State of Oregon, do hereby make application for a certificate of registration, as evidence of a right to appropriate ground water.

1. Source from which water is withdrawn is flowing Rimp Well  
(Flowing well, pump well, infiltration trench, or tunnel)

2. Location is: \_\_\_\_\_  
(Approximate distance and direction from nearest city or town)

and is more particularly described as follows:

(a) 1892 Ch S x 1 Ch E from NW corner Sect 5  
being within NW 1/4 NE 1/4 of Sec. 15, Twp. 6 S, Rge. 2 W  
(Smallest legal subdivision) (N. or S.) (E. or W.)

or (b) within limits of recorded platted property, town or city: \_\_\_\_\_

in Lot \_\_\_\_\_, Block \_\_\_\_\_ of \_\_\_\_\_  
(Name of plat or addition)

County of \_\_\_\_\_  
(If within city or town, give name)

3. Construction Work was begun on Oct. 53; was completed on Oct 53  
(Date) (Date)

and the ground water claimed was first used for the purposes set out below on May 1954  
(Date)

since which time the water has been used Continuously  
(Continuously or intermittently)

from May 1954 to July 1958  
(Date) (Date)

4. Quantity of water claimed and used is 200 gallons per minute; \_\_\_\_\_ acre feet per year.

5. Purpose or Purposes for which water is used Irrigation

(Domestic, irrigation, municipal, manufacturing, industrial, etc.)

6. Description of Well: Depth 155 feet. Type Drilled  
(Dug or drilled)

diameter 8 inches. Elevation of ground at well site \_\_\_\_\_ feet, mean sea level.  
(As near as known)

Depth to water table 135 feet.

7. Capacity of Well: 900 g.p.m. with 40 feet drawdown.

\_\_\_\_\_ g.p.m. with \_\_\_\_\_ feet drawdown.

Date of test May 1954

If Flowing Well: Measured discharge \_\_\_\_\_ g.p.m. on \_\_\_\_\_  
(Date)

Shut-in pressure at ground surface \_\_\_\_\_ lbs. per sq. in. on \_\_\_\_\_  
(Date)

Water is controlled by \_\_\_\_\_  
(Cap, valve, etc.)



If log of well is not available, give name and address of driller. \_\_\_\_\_

*Public Stable*

11. Infiltration Trench: Covered or open \_\_\_\_\_

Dimensions: Length \_\_\_\_\_ ft. Minimum depth \_\_\_\_\_ ft. Maximum depth \_\_\_\_\_ ft.

Bottom width \_\_\_\_\_ ft. Discharge \_\_\_\_\_ g.p.m. Date of test \_\_\_\_\_

12. Tunnel: Type of lining \_\_\_\_\_

Dimensions: \_\_\_\_\_  
(Length, course, and cross sectional size)

Position of water bearing stratum with reference to portal of tunnel \_\_\_\_\_

Log of tunnel: (Preceding table for log of well may be used, if desired. Give footage from portal and character of materials, as pertinent.)

13. Pumping Equipment:

(a) Pump *Turbine* Capacity *250* g.p.m.

(Make, type and size)

(b) Motor *10 H.P. 3 phase S.E.*

(Type and horsepower)


14. Location of area irrigated or to be irrigated, or place of use if for purposes other than irrigation.

Township North or South	Range E. or W. of Willamette Meridian	Section	Forty-acre Tract	Number Acres To Be Irrigated	Date of Reclamation
<i>6S</i>	<i>2W</i>	<i>15</i>	<i>NW 1/4 NE 1/4</i>	<i>10</i>	<i>1954</i>
<del><i>6S</i></del>	<del><i>2W</i></del>	<del><i>15</i></del>	<del><i>NE 1/4 NW 1/4</i></del>	<del><i>12 1/2</i></del>	<del><i>"</i></del>
<del><i>6S</i></del>	<del><i>2W</i></del>	<del><i>15</i></del>	<del><i>NW 1/4 NW 1/4</i></del>	<del><i>5</i></del>	<del><i>"</i></del>
<i>"</i>	<i>"</i>	<i>"</i>	<i>SW 1/4 NW 1/4</i>	<i>2</i>	<i>"</i>
<i>"</i>	<i>"</i>	<i>"</i>	<i>SE 1/4 NW 1/4</i>	<i>12</i>	<i>"</i>
<i>"</i>	<i>"</i>	<i>"</i>	<i>SW 1/4 NE 1/4</i>	<i>8</i>	<i>"</i>
			<i>Total</i>	<i>49 1/2</i>	<i>"</i>

15. If the ground water supply is supplemental to an existing water supply, identification of any application for a permit, permit, certificate or adjudicated right to appropriate water made or held by the registrant.

*None*

Township 16 S Range 2 W W.M.  
North

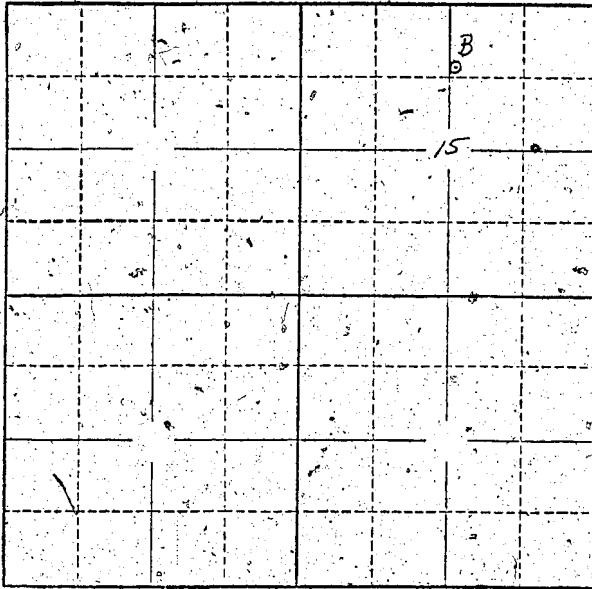

Locate well and acreage of irrigated land on plat.  
Scale: 2" = 1 Mile

STATE OF OREGON

County of Marion } ss.

I, Frank Henry, being first duly sworn, do hereby certify that I have read the foregoing Registration Statement and that all of the items therein contained are true to the best of my knowledge and belief.

Frank Henry  
(Signature of Registrant)

Subscribed and sworn to before me this 30th day of July, 1958

My commission expires 12th June 1961 Wm. S. Bartholomew  
(Notary Public)

(SEAL)

### CERTIFICATE OF REGISTRATION

STATE OF OREGON

County of Marion } ss.

This is to certify that the foregoing Registration Statement was received in the office of the State Engineer on the 31st day of July, 1958, at 2:10 o'clock A. M. and has been duly recorded in said office in Book No. 13 of Registration Statements on page GR-3034.

Witness my hand this 8th day of June, 1959

Lewis A. Stanley  
(State Engineer)

By: \_\_\_\_\_  
(Deputy)

GR-3034

\$18.00