

Registration Statement

OF CLAIMANT OF RIGHT TO APPROPRIATE GROUND WATER

TO THE STATE ENGINEER OF OREGON:

I, Jenny Barchus
of RT 1, Box 273, Brooks County of Marion
(Mailing address)
State of Oregon, do hereby make application for a certificate of registration as evidence of a right to appropriate ground water.

- *1. Source from which water is withdrawn is Pump Well
(Flowing well, pump well, infiltration trench, or tunnel)
- *2. Location is: 1 mile east of Brooks
(Approximate distance and direction from nearest city or town)

and is more particularly described as follows:

(a) 1500' due South from SE Corner Harvey Smith D.L.C No. 66
(Give distance and bearing to corner of section or other legal subdivision)
being within NE 1/4 NW 1/4 of Sec. 21 Twp. 6 S Rge. 2 W
(Smallest legal subdivision) (N. or S.) (E. or W.)

or (b) within limits of recorded platted property, town or city:
in Lot _____, Block _____ of _____
(Name of plat or addition)
County of _____
(If within city or town, give name)

3. Construction Work was begun on MAY 1, 1955, was completed on June 1, 1955
(Date) (Date)
and the ground water claimed was first used for the purposes set out below on July 1, 1955
(Date)
since which time the water has been used Intermittently
(Continuously or intermittently)
from July 1, 55 to July 30, 58
(Date) (Date)

4. Quantity of water claimed and used is 188 gallons per minute; _____ acre feet per year.

5. Purpose or Purposes for which water is used Domestic and Irrigation

6. Description of Well: Depth 99 feet. Type Dug Drilled
(Domestic, irrigation, municipal, manufacturing, industrial, etc.) (Dug or drilled)
diameter 10 inches. Elevation of ground at well site _____ feet, mean sea level.
(As near as known)
Depth to water table 10 feet.

7. Capacity of Well: 550 g.p.m. with 60 feet drawdown.
100 g.p.m. with 21 feet drawdown.

Date of test June 1, 1955

If Flowing Well: Measured discharge _____ g.p.m. on _____
(Date)

Shut-in pressure at ground surface _____ lbs. per sq. in. on _____
(Date)

Water is controlled by _____
(Cap, valve, etc.)

8. Casing: (Give diameter, commercial specifications and depth below ground surface of each casing size.)

1.0 inch diameter steel casing from 0 to 99 feet
 inch diameter from to feet
 inch diameter from to feet
 inch diameter from to feet

Describe and show depth of shoe, plug, adapter, liner or other details:

9. Perforated Casings or Screens:

36 ROWS OF 10 CUTS PER ROW from 78 to 99
(Number per foot and size of perforations, or describe screen)
 FROM 78 FT TO 99 FT from to
 from to
 from to
 from to

10. Log of Well: (Describe each stratum or formation clearly, indicate if water bearing, and give thickness and depth as indicated.)

MATERIAL	Thickness (Feet)	Depth to Bottom (Feet)
TOP SOIL		5 FT
YELLOW SHALE + SILT		18 FT
BLUE SHALE		32 FT
HARD BLUE SHALE		62 FT
SHALE + GRAVEL		75
BLUE SAND + GRAVEL		76
BROWN SAND + COARSE GRAVEL (WATER)		99
BROWN SAND + GRAVEL WITH SHALE (HARD)		?

If log of well is not available, give name and address of driller. Willamette Drilling

11. Infiltration Trench: Covered or open _____
 Dimensions: Length _____ ft. Minimum depth _____ ft. Maximum depth _____ ft.
 Bottom width _____ ft. Discharge _____ g.p.m. Date of test _____

12. Tunnel: Type of lining _____
 Dimensions: _____ (Length, course, and sectional size)
 Position of water bearing stratum with reference to portal of tunnel _____

Log of tunnel: (Preceding table for log of well may be used, if desired. Give footage from portal and character of materials, as pertinent.)

13. Pumping Equipment:
 (a) Pump RIEDANKS MORSE CENTRI Capacity 200 g.p.m.
(Make, type and size)
 (b) Motor 7 1/2 HP. SINGLE PHASE ELECTRIC
(Type and horsepower)


14. Location of area irrigated or to be irrigated, or place of use if for purposes other than irrigation.

Township North or South	Range E. or W. of Willamette Meridian	Section	Forty-acre Tract	Number Acres To Be Irrigated	Date of Reclamation
6 S	2W	21	NE 1/4 NW 1/4	4	July 1955
"	"	"	SE 1/4 NW 1/4	10	"
"	"	"	SW 1/4 NE 1/4	6	"
Total				20	

15. If the ground water supply is supplemental to an existing water supply, identification of any application for a permit, permit, certificate or adjudicated right to appropriate water made or held by the registrant.

SE Corner D.L.C. 66

Township 65 Range 2 W, W.M.
North

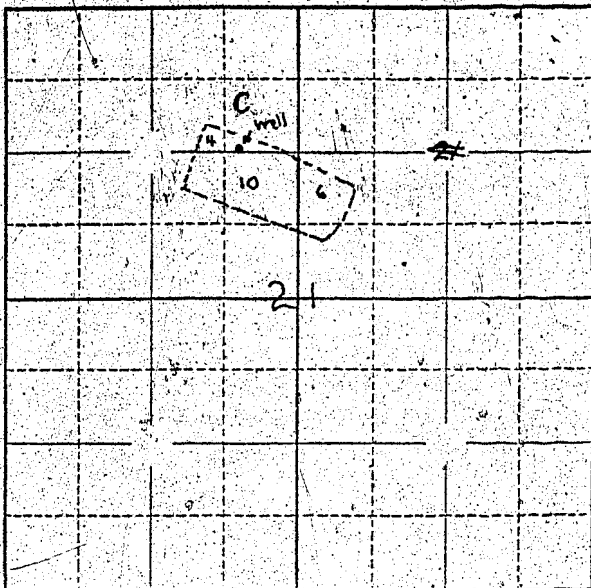

Locate well and acreage of irrigated land on plat.
Scale: $\frac{1}{4}$ inch = 1 Mile

STATE OF OREGON

County of Marion } ss.

I, Jerry Barchus, being first duly sworn, do hereby certify that I have read the foregoing Registration Statement and that all of the items therein contained are true to the best of my knowledge and belief.

Jerry Barchus
(Signature of Registrant)

Subscribed and sworn to before me this 30th day of July, 1958

My commission expires 12th June 1961 Wm. D. Bartholomew
(Notary Public)

(SEAL)

CERTIFICATE OF REGISTRATION

STATE OF OREGON

County of Marion } ss.

This is to certify that the foregoing Registration Statement was received in the office of the State Engineer on the 30th day of July, 1958, at 2:30 o'clock P.M. and has been duly recorded in said office in Book No. 17 of Registration Statements on page GR-4083

Witness my hand this 16th day of May, 1960

LEWIS A. STANLEY
(State Engineer)

By Max F. Rogers
(Deputy)

GR 4083

\$15.00