

#1

REGISTRATION NO. GR-3266
CERTIFICATE NO. GR-3038

Registration Statement

OF CLAIMANT OF RIGHT TO APPROPRIATE GROUND WATER

(Under Chapter 708, Oregon Laws 1955.)

TO THE STATE ENGINEER OF OREGON:

I, Aage Gribskov
of Junction City County of Lane

State of Oregon, do hereby make application for a certificate of registration as evidence of a right to appropriate ground water.

1. Source from which water is withdrawn is pump well
(Flowing well, pump well, infiltration trench, or tunnel)

2. Location is: 1 mile east of Junction City
(Approximate distance and direction from nearest city or town)

and is more particularly described as follows:

(a) 3775' N 5°-30' E from S.W. Cor. Sec. 33
(Give distance and bearing to corner of section or other legal subdivision)

being within S.W. 1/4 of N.W. 1/4 of Sec. 33, Twp. 15-S, Rge. 4-W
(smallest legal subdivision) (N. or S.) (E. or W.)

or (b) within limits of recorded platted property, town or city:

in Lot 19, Block of Milletts Plat
(Name of plat or addition)

County of Lane
(If within city or town, give name)

3. Construction Work was begun on June 1944; was completed on June 1944
(Date) (Date)

and the ground water claimed was first used for the purposes set out below on July 1944
(Date)

since which time the water has been used intermittently, even summer
(Continuously or Intermittently)

from May to Sept
(Date) (Date)

4. Quantity of water claimed and used is 200 gallons per minute; 80 acre feet per year.

5. Purpose or Purposes for which water is used irrigation at farm 3000

(Domestic, irrigation, municipal, manufacturing, industrial, etc.)

6. Description of Well: Depth 22 feet. Type 2 casing 12" dia 12' apart
(Dug or drilled)

diameter 7 inches. Elevation of ground at well site 317 feet, mean sea level.
(As near as known)

Depth to water table 12 feet.

7. Capacity of Well: 350 g.p.m. with 3 feet drawdown.

g.p.m. with _____ feet drawdown.

Date of test _____

If Flowing Well: Measured discharge _____ g.p.m. on _____
(Date)

Shut-in pressure at ground surface _____ lbs. per sq. in. on _____
(Date)

Water is controlled by _____
(Cap, valve, etc.)

8. Casing: (Give diameter, commercial specifications and depth below ground surface of each casing size.)

(2) 4 inch diameter from 0 to 22 feet
..... inch diameter from to feet
..... inch diameter from to feet
..... inch diameter from to feet

Describe and show depth of shoe, plug, adapter, liner or other details:

Two (2) 4" pipes together w/ "T" at surface

9. Perforated Casings or Screens:

standard perforations from 18 to 22
(Number per foot and size of perforations, or describe screen)
..... from to
..... from to
..... from to

10. Log of Well: (Describe each stratum or formation clearly, indicate if water bearing, and give thickness and depth as indicated.)

MATERIAL	Thickness (Feet)	Depth to Bottom (Feet)
Top soil (loam)	6	16
Sand & gravel	16	0

If log of well is not available, give name and address of driller: Walter Nelson

Junction City, Oregon

11. **Infiltration Trench:** Covered or open
 Dimensions: Length ft. Minimum depth ft. Maximum depth ft.
 Bottom width ft. Discharge g.p.m. Date of test

12. **Tunnel:** Type of lining
 Dimensions:
 (Length, course, and cross sectional size)

Position of water bearing stratum with reference to portal of tunnel

Log of tunnel: (Preceding table for log of well may be used, if desired. Give footage from portal and character of materials, as pertinent.)


13. **Pumping Equipment:**
 (a) Pump Goulds 4"x3" Capacity 500 g.p.m.
 (Make, type and size)
 (b) Motor A.P., 2hp 1725 RPM - G.E.
 (Type and horsepower)

14. Location of area irrigated or to be irrigated, or place of use if for purposes other than irrigation.

Township North or South	Range E. or W. of Willamette Meridian	Section	Forty-acre Tract	Number Acres To Be Irrigated	Date of Reclamation
<u>15-S</u>	<u>4-W</u>	<u>33</u>	<u>S.W. 1/4 of NW 1/4</u>	<u>33</u>	<u>1944</u>

15. If the ground water supply is supplemental to an existing water supply, identification of any application for a permit, permit, certificate or adjudicated right to appropriate water made or held by the registrant.

Township 15S Range 4W W.M.
North

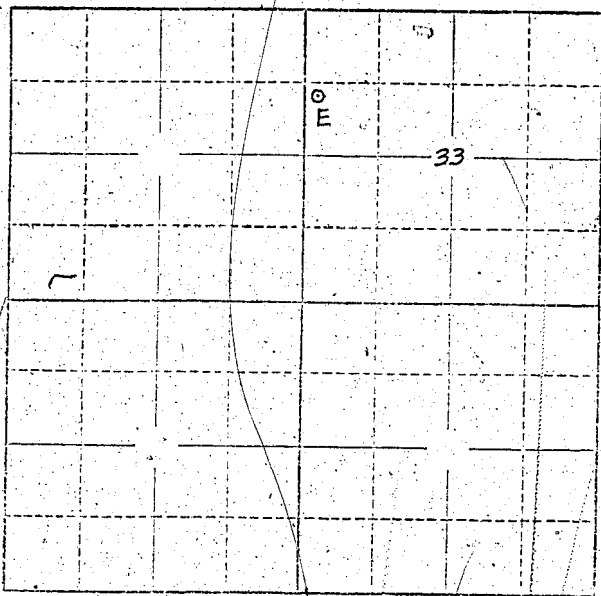

Locate well and acreage of irrigated land on plat.
Scale: 2" = 1 Mile

STATE OF OREGON

County of Linn } ss.

I, Roger Gribelov, being first duly sworn, do hereby certify that I have read the foregoing Registration Statement and that all of the items therein contained are true to the best of my knowledge and belief.

Roger Gribelov
(Signature of Registrant)

Subscribed and sworn to before me this 29th day of July, 1958

My commission expires April 11, 1960 Julian H. Smith
(Notary Public)

(SEAL)

CERTIFICATE OF REGISTRATION

STATE OF OREGON

County of Marion } ss.

This is to certify that the foregoing Registration Statement was received in the office of the State Engineer on the 30th day of July, 1958, at 2:45 o'clock P. M. and has been duly recorded in said office in Book No. 13 of Registration Statements on page GR 3038

~~X Construction shall be completed by 19 and the water completely applied to beneficial use by 19.~~

Witness my hand this 6th day of June, 1959

Lawrence A. Stanley
(State Engineer)

By _____
(Deputy)

GR-3038

7/5/58