

Registration Statement

OF CLAIMANT OF RIGHT TO APPROPRIATE GROUND WATER

TO THE STATE ENGINEER OF OREGON:

I, Willis M. Bartlett

of Brooks County of Marion

State of Oregon do hereby make application for a certificate of registration as evidence of a right to appropriate ground water.

1. Source from which water is withdrawn is Pump Well
(Flowing well, pump well, infiltration trench, or tunnel)

2. Location is: 4 miles N. 60° East from Brooks
(Approximate distance and direction from nearest city or town)

and is more particularly described as follows: about 410 feet west & 460 feet south from NW cor of NE 1/4 of SW 1/4

(a) S 80° 30' E S275'
(Give distance and bearing to corner of section or other legal subdivision)

being within NE 1/4 of SW 1/4 of Sec. 12, Twp. 6 S, Rge. 2 W
(Smallest legal subdivision) (N. or S.) (E. or W.)

or (b) within limits of recorded platted property, town or city:

in Lot 6 + 4, Block --- of Hayes Labish Farms Subdivision #3
(Name of plat or addition)

County of Marion
(If within city or town, give name)

3. Construction Work was begun on Unknown; was completed on Unknown
(Date) (Date)

and the ground water claimed was first used for the purposes set out below on Unknown
(Date)

since which time the water has been used Continuously
(Continuously or intermittently)

from 1938 to Present
(Date) (Date)

4. Quantity of water claimed and used is 800 gallons per minute; ~~26000~~ g. acre feet per year.

5. Purpose or Purposes for which water is used

Irrigation
(Domestic, irrigation, municipal, manufacturing, industrial, etc.)

6. Description of Well: Depth 620 feet. Type Drilled
(Dug or drilled)

diameter 8 inches. Elevation of ground at well site 150 feet, mean sea level.
(As near as known)

Depth to water table ? feet.

7. Capacity of Well: g.p.m. with feet drawdown.

 g.p.m. with feet drawdown.

Date of test

If Flowing Well: Measured discharge g.p.m. on (Date)

Shut-in pressure at ground surface lbs. per sq. in. on (Date)

Water is controlled by
(Csp, valve, etc.)

Neighbor advised Sneed & Sons dug well
2505 Brooks St.,
Salem, Oregon

8. Casing: (Give diameter, commercial specifications and depth below ground surface of each casing size.)

..... inch diameter *unk* from to feet
..... inch diameter from to feet
..... inch diameter from to feet
..... inch diameter from to feet

Describe and show depth of shoe, plug, adapter, liner or other details:
.....
.....

9. Perforated Casings or Screens:

unk from to
(Number per foot and size of perforations, or describe screen)
..... from to
..... from to
..... from to

10. Log of Well: (Describe each stratum or formation clearly; indicate if water bearing, and give thickness and depth as indicated.)

MATERIAL	Thickness (Feet)	Depth to Bottom (Feet)
<i>unk</i>		

If log of well is not available, give name and address of driller. *unk*

11. Infiltration Trench: Covered or open

Dimensions: Length ft. Minimum depth ft. Maximum depth ft.
 Bottom width ft. Discharge g.p.m. Date of test

12. Tunnel: Type of lining

Dimensions:
(Length, course, and cross sectional size)
 Position of water bearing stratum with reference to portal of tunnel

Log of tunnel: (Preceding table for log of well may be used, if desired. Give footage from portal and character of materials, as pertinent.)

13. Pumping Equipment:

(a) Pump *Turbine Pump* Capacity 1000 g.p.m.
(Make, type and size)
 (b) Motor 20 Hp Gasoline Tractor Engine
(Type and horsepower)

14. Location of area irrigated or to be irrigated, or place of use if for purposes other than irrigation.


Township North or South	Range E. or W. of Willamette Meridian	Section	Forty-acre Tract	Number Acres To Be Irrigated	Date of Reclamation
T6S	2 West	12	SE 1/4 of NW 1/4	4.20	1938 Unknown
"	"	"	NE 1/4 of SW 1/4	19.35	"
				<u>23.55</u>	

15. If the ground water supply is supplemental to an existing water supply, identification of any application for a permit, permit, certificate or adjudicated right to appropriate water made or held by the registrant.

Section 12

See Map

Township 6 S Range 2 West, W.M.
North

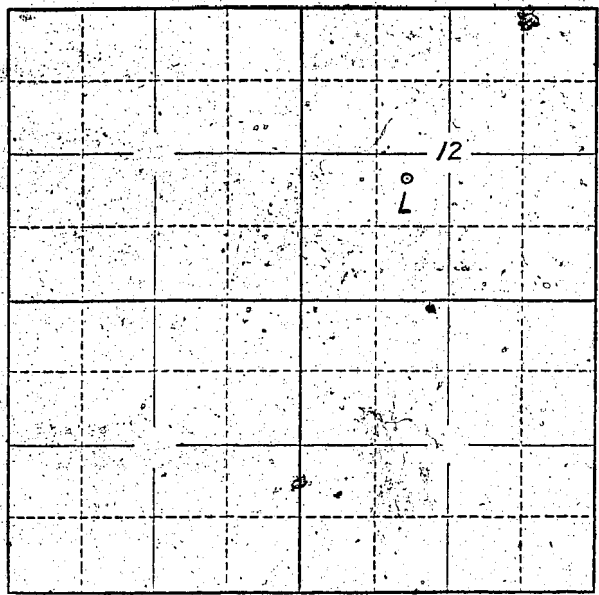

Locate well and acreage of irrigated land on plat.
Scale: 2" = 1 Mile

STATE OF OREGON

County of Marion } ss.

I, Willis W. Bennett, being first duly sworn, do hereby certify that I have read the foregoing Registration Statement and that all of the items therein contained are true to the best of my knowledge and belief.

Willis W. Bennett
(Signature of Registrant)

Subscribed and sworn to before me this 30th day of July, 1956

My commission expires 4-19-61

Frank A. Green
(Notary Public)

(SEAL)

CERTIFICATE OF REGISTRATION

STATE OF OREGON

County of Marion } ss.

This is to certify that the foregoing Registration Statement was received in the office of the State Engineer on the 31st day of July, 1956, at 8⁰⁰ o'clock A. M. and has been duly recorded in said office in Book No. 13 of Registration Statements on page GR-3040

Witness my hand this 8th day of June, 1959

Lewis A. Stanley
(State Engineer)

By _____
(Deputy)

GR-3040

\$15.00