

RECEIVED

STATE ENGINEER
SALEM, OREGON

REGISTRATION NO. GR-327

Registration Statement CERTIFICATE NO. GR-309

OF CLAIMANT OF RIGHT TO APPROPRIATE GROUND WATER

(Under Chapter 708, Oregon Laws 1955.)

TO THE STATE ENGINEER OF OREGON:

I, Marvin W. and Helen E. Fletcher

of Route 2, Box 315, Albany County of Linn

State of Oregon, do hereby make application for a certificate of registration as evidence of a right to appropriate ground water.

1. Source from which water is withdrawn is pump well No. 1

(Flowing well, pump well, infiltration trench, or tunnel)

2. Location is: 10 miles North of Albany, Oregon

(Approximate distance and direction from nearest city or town)

and is more particularly described as follows:

(a) 40 chains west from the NE corner of SE $\frac{1}{4}$, S. 13, T. 10 S. R 4 W.

(Give distance and bearing to corner of section or other legal subdivision)

being within SW $\frac{1}{4}$ of NE $\frac{1}{4}$ of Sec. 13, Twp. 10 S. Rge. 4 W.

(Smallest legal subdivision)

(N. or S.)

(E. or W.)

or (b) within limits of recorded platted property, town or city:

in Lot _____, Block _____ of _____

(Name of plat or addition)

County of Linn

(If within city or town, give name)

3. Construction Work was begun on October 1, 1951; was completed on October 3, 1951

(Date)

(Date)

and the ground water claimed was first used for the purposes set out below on June 15, 1952

(Date)

since which time the water has been used continuously

(Continuously or intermittently)

from June 15, 1952 to present time

(Date)

(Date)

4. Quantity of water claimed and used is 170 gallons per minute; 39.5 acre feet per year.

5. Purpose or Purposes for which water is used irrigation

(Domestic, irrigation, municipal, manufacturing, industrial, etc.)

6. Description of Well: Depth 32 feet. Type drilled

(Dug or drilled)

diameter 8 inches. Elevation of ground at well site 185 feet, mean sea level.

(As near as known)

Depth to water table 12 feet.

7. Capacity of Well: 170 g.p.m. with 14 feet drawdown.

_____ g.p.m. with _____ feet drawdown.

Date of test not tested

If Flowing Well: Measured discharge _____ g.p.m. on _____

(Date)

Shut-in pressure at ground surface _____ lbs. per sq. in. on _____

(Date)

Water is controlled by _____

(Cap, valve, etc.)

8. Casing: (Give diameter, commercial specifications and depth below ground surface of each casing size.)

8 inch diameter steel casing from 0 to 32 feet
 inch diameter from to feet
 inch diameter from to feet
 inch diameter from to feet

Describe and show depth of shoe, plug, adapter, liner or other details:

9. Perforated Casings or Screens:

Slit perforations from 17 to 32
 (Number per foot and size of perforations, or describe screen)
 from to
 from to
 from to

10. Log of Well: (Describe each stratum or formation clearly; indicate if water bearing, and give thickness and depth as indicated.)

MATERIAL	Thickness (Feet)	Depth to Bottom (Feet)
Notavailable		

127-226

Beginning at a point which is 9.04 chains South and 5.90 chains East of the Southeast corner of the D.L.C. of Elias A. Johnson, Not. No. 1717, Claim No. 74 in T. 10 S., R. 4 W. of the Will. Mer. in Linn County, Oregon; and running thence West parallel with the North boundary line of Claim No. 72 in said T. and R. 41.45 chains to the center of a county road, thence S.3°44'E. along the center of said county road 13.88 chains to the South boundary line of a tract of land conveyed to Alfred C. Schultz and John H. Mulligan by Kola Weis by deed recorded on page 22, Vol. 90, Deed Records of Linn County, Oregon; thence East parallel with the North boundary line of Claim No. 72 said T. and R. 40.54 chains to the Southeast corner of said tract of land conveyed to Alfred C. Schultz and John H. Mulligan aforesaid; thence N. 5.35 chains, thence N. 52°15'E. 15.15 chains; thence West 12.00 chains to a point due North of the place of beginning, thence South 34 links to the place of beginning, containing 62.13 acres, more or less.

GR-309 A

If log of well is not available, give name and address of driller. Nicholas Klaus, Route 4

Albany, Oregon

11. Infiltration Trench: Covered or open _____

Dimensions: Length _____ ft. Minimum depth _____ ft. Maximum depth _____ ft.

Bottom width _____ ft. Discharge _____ g.p.m. Date of test _____

12. Tunnel: Type of lining _____

Dimensions: _____
(Length, course, and cross sectional size)

Position of water bearing stratum with reference to portal of tunnel _____

Log of tunnel: (Preceding table for log of well may be used, if desired. Give footage from portal and character of materials, as pertinent.)

13. Pumping Equipment:

(a) Pump Fairbanks Morse 2" centrifugal Capacity 200 g.p.m.
(Make, type and size)


(b) Motor 10 H.P. electric
(Type and horsepower)

14. Location of area irrigated or to be irrigated, or place of use if for purposes other than irrigation.

Township North or South	Range E. or W. of Willamette Meridian	Section	Forty-acre Tract	Number Acres To Be Irrigated	Date of Reclamation
10 S.	4 W.	13	SW $\frac{1}{4}$ of NE $\frac{1}{4}$	0.6	June 15, 1952
10 S.	4 W.	13	NW $\frac{1}{4}$ of SE $\frac{1}{4}$	15.2	June 15, 1952
				<u>15.8</u>	

15. If the ground water supply is supplemental to an existing water supply, identification of any application for a permit, permit, certificate or adjudicated right to appropriate water made or held by the registrant.

Township 10 S. Range 3 & 4 W.M.
North

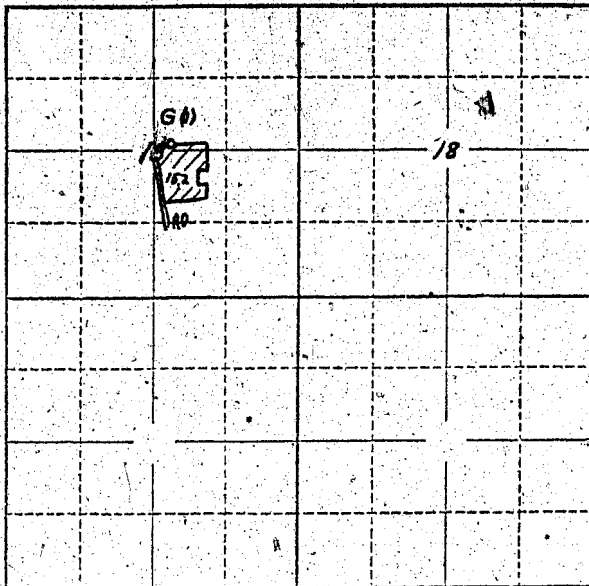

Locate well and acreage of irrigated land on plat.

Scale: 2" = 1.Mile

STATE OF OREGON

County of Linn

ss.

I, Marvin W. and Helen E. Fletcher, being first duly sworn, do hereby certify that I have read the foregoing Registration Statement and that all of the items therein contained are true to the best of my knowledge and belief.

Marvin W. Fletcher
Helen E. Fletcher

(Signature of Registrant)

Subscribed and sworn to before me this 3 day of Jan, 1957.

My commission expires NOTARY PUBLIC FOR OREGON

My Commission Expires May 2, 1959

(Notary Public)

(SEAL)

SEE PAGE GR-309 G FOR
CERTIFICATE OF REGISTRATION

STATE OF OREGON

County of Marion

ss.

~~This is to certify that the foregoing Registration Statement was received in the office of the State Engineer in the year of 1957 and has been duly recorded in said office in Book No. of Registration Statement on page~~

~~Construction shall be completed by 1958 and the water completely applied to beneficial use by 1959~~

~~Witness my hand this 1st day of December 1957~~

(State Engineer)

By

(Deputy)

GR-309C

OF CLAIMANT OF RIGHT TO APPROPRIATE GROUND WATER

(Under Chapter 708, Oregon Laws 1955.)

TO THE STATE ENGINEER OF OREGON:

I, Marvin W. and Helen E. Fletcher

of Route 2, Box 315, Albany County of Linn

State of Oregon, do hereby make application for a certificate of registration as evidence of a right to appropriate ground water.

1. Source from which water is withdrawn is pump well No. 2
(Flowing well, pump well, infiltration trench, or tunnel)

2. Location is: 10 miles north of Albany, Oregon
(Approximate distance and direction from nearest city or town)

and is more particularly described as follows:

(a) S. 7.5 chains from the NE corner of SE 1/4 S. 13, T. 10 S., R. 4 W.
(Give distance and bearing to corner of section or other legal subdivision)

being within N 1/4 of SW 1/4 of Sec. 18, Twp. 10/S., Rge. 3 W.
(Smallest legal subdivision) (N. or S.) (E. or W.)

or (b) within limits of recorded platted property, town or city:

in Lot _____, Block _____ of _____
(Name of plat or addition)

County of Linn
(If within city or town, give name)

3. Construction Work was begun on June 25, 1954, was completed on June 27, 1954
(Date) (Date)

and the ground water claimed was first used for the purposes set out below on June 15, 1955
(Date)

since which time the water has been used continuously
(Continuously or intermittently)

from June 15, 1955 to Present time
(Date) (Date)

4. Quantity of water claimed and used is 200 gallons per minute; 44 acre feet per year.

5. Purpose or Purposes for which water is used Irrigation
(Domestic irrigation, municipal, manufacturing, industrial, etc.)

6. Description of Well: Depth 35 feet. Type drilled
(Dug or drilled)

diameter 8 inches. Elevation of ground at well site 180 feet, mean sea level.
(As near as known)

Depth to water table 10 feet.

7. Capacity of Well: 200 g.p.m. with 12 feet drawdown.

g.p.m. with _____ feet drawdown.

Date of test not tested

If Flowing Well: Measured discharge _____ g.p.m. on _____
(Date)

Shut-in pressure at ground surface _____ lbs. per sq. in. on _____
(Date)

Water is controlled by _____
(Cap, valve, etc.)

GR-309 D

8. Casing: (Give diameter, commercial specifications and depth below ground surface of each casing size.)

8 inch diameter steel casing from 0 to 35 feet
..... inch diameter from to feet
..... inch diameter from to feet
..... inch diameter from to feet

Describe and show depth of shoe, plug, adapter, liner or other details:

9. Perforated Casings or Screens:

slit perforations from 20 to 35
(Number per foot and size of perforations, or describe screen)
..... from to
..... from to
..... from to

10. Log of Well: (Describe each stratum or formation clearly, indicate if water bearing, and give thickness and depth as indicated.)

MATERIAL	Thickness (Feet)	Depth to Bottom (Feet)
Not available		

If log of well is not available, give name and address of driller. Nicholas Klaus, Route 4,
Albany, Oregon.

11. Infiltration Trench: Covered or open _____
 Dimensions: Length _____ ft. Minimum depth _____ ft. Maximum depth _____ ft.
 Bottom width _____ ft. Discharge _____ g.p.m. Date of test _____

12. Tunnel: Type of lining _____
 Dimensions: _____
(Length, course, and cross sectional size)
 Position of water bearing stratum with reference to portal of tunnel _____

Log of tunnel: (Preceding table for log of well may be used, if desired. Give footage from portal and character of materials, as pertinent.)


13. Pumping Equipment:
 (a) Pump Fairbanks Morse 2nd centrifugal Capacity 200 g.p.m.
(Make, type and size)
 (b) Motor 10 H.P. electric
(Type and horsepower)

14. Location of area irrigated or to be irrigated, or place of use if for purposes other than irrigation.

Township North or South	Range E. or W. of Willamette Meridian	Section	Forty-acre Tract	Number Acres To Be Irrigated	Date of Reclamation
10 S.	3 W.	18	SW $\frac{1}{4}$ of NW $\frac{1}{4}$	0.8	June 15, 1955
10 S.	3 W.	18	NW $\frac{1}{4}$ of SW $\frac{1}{4}$	4.8	June 15, 1955
10 S.	4 W.	13	SE $\frac{1}{4}$ of NE $\frac{1}{4}$	0.8	June 15, 1955
10 S.	4 W.	13	NE $\frac{1}{4}$ of SE $\frac{1}{4}$	11.2	June 15, 1955
				<u>17.6</u>	

15. If the ground water supply is supplemental to an existing water supply, identification of any application for a permit, permit, certificate or adjudicated right to appropriate water made or held by the registrant.

Township 10 S. Range 3 & 4 W.M. North

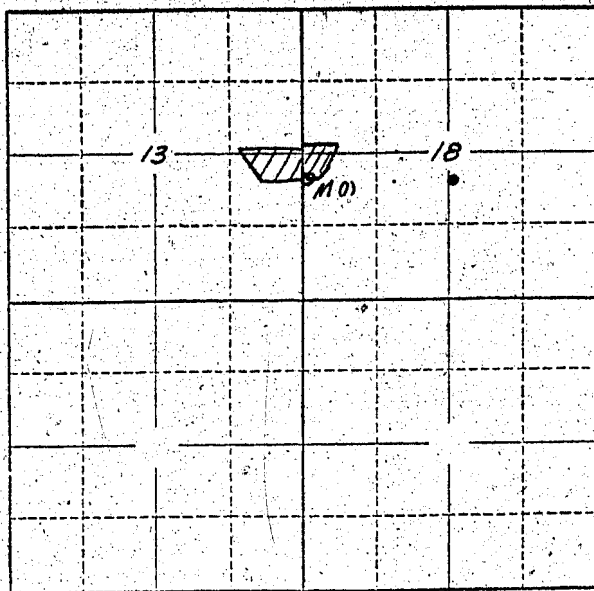

Locate well and acreage of irrigated land on plat.
Scale: 2" = 1 Mile

STATE OF OREGON }
County of Linn } ss.

I, Marvin W. and Helen E. Fletcher, being first duly sworn, do hereby certify that I have read the foregoing Registration Statement and that all of the items therein contained are true to the best of my knowledge and belief.

Marvin W. Fletcher
Helen E. Fletcher
(Signature of Registrant)

Subscribed and sworn to before me this 9 day of Jan, 1957

My commission expires NOTARY PUBLIC FOR OREGON
My Commission Expires July 2, 1959
Claris L. Holland
(Notary Public)

(SEAL)

CERTIFICATE OF REGISTRATION

STATE OF OREGON }
County of Marion } ss.

This is to certify that the foregoing Registration Statement was received in the office of the State Engineer on the 14th day of January, 1957, at 9 o'clock A. M. and has been duly recorded in said office in Book No. 2 of Registration Statements on page GR-309 C

~~Construction shall be completed by X-X-X-X-X-X-X-X-X-X-X-X-X-X and the water completely applied to beneficial uses by X-X-X-X-X-X-X-X-X-X-X-X-X-X~~

Witness my hand this 14th day of March, 1957.

Lewis A. Stanley
(State Engineer)

By _____
(Deputy)

GR-309 G

1562