

Registration Statement

OF CLAIMANT OF RIGHT TO APPROPRIATE GROUND WATER

TO THE STATE ENGINEER OF OREGON:

I, Percy Dunn
of Rt 2 Box 207, Silverton County of Marion
(Mailing address)

State of Oregon, do hereby make application for a certificate of registration as evidence of a right to appropriate ground water.

1. Source from which water is withdrawn is pump well
(Flowing well, pump well, infiltration trench, or tunnel)

2. Location is: 7 mi NE Silverton, Oregon
(Approximate distance and direction from nearest city or town)

and is more particularly described as follows:

(a) 1205', N 23° 15' W from the SE Cor. Sec. 24 T 6 S R 2W
(Give distance and bearing to corner of section or other legal subdivision)

being within SE 1/4 of the SE 1/4 of Sec. 24, Twp. 6 S, Rge. 2 W
(Smallest legal subdivision) (N. or S.) (E. or W.)

or (b) within limits of recorded platted property, town or city:

in Lot _____, Block _____ of _____
(Name of plat or addition)

_____ County of _____
(If within city or town, give name)

3. Construction Work was begun on May 1955; was completed on May 23 1955
(Date) (Date)

and the ground water claimed was first used for the purposes set out below on June 1955
(Date)

since which time the water has been used continuously
(Continuously or intermittently)

from June 1955 to _____ date _____
(Date) (Date)

4. Quantity of water claimed and used is 200 gallons per minute; _____ acre feet per year.

5. Purpose or Purposes for which water is used: irrigation
(Domestic, irrigation, municipal, manufacturing, industrial, etc.)

6. Description of Well: Depth: 110 feet. Type drilled
(Dug or drilled)

diameter 8 inches. Elevation of ground at well site 190 feet, mean sea level.
(As near as known)

Depth to water table 31 feet.

7. Capacity of Well: 100 g.p.m. with 51 feet drawdown.

300 g.p.m. with 120 feet drawdown.

Date of test May 23 1955

If Flowing Well: Measured discharge _____ g.p.m. on _____
(Date)

Shut-in pressure at ground surface _____ lbs. per sq. in. on _____
(Date)

Water is controlled by _____
(Cap, valve, etc.)

8. Casing: (Give diameter, commercial specifications and depth below ground surface of each casing size.)

8 inch diameter Steel casing from 0 to 110 feet
 inch diameter from to feet
 inch diameter from to feet
 inch diameter from to feet

Describe and show depth of shoe, plug, adapter, liner or other details:

9. Perforated Casings or Screens:

36 rows of 8 cuts per row mills perforator from 100 to 110
 (Number per foot and size of perforations, or describe screen)
 from to
 from to
 from to

10. Log of Well: (Describe each stratum or formation clearly, indicate if water bearing, and give thickness and depth as indicated.)

MATERIAL	Thickness (Feet)	Depth to Bottom (Feet)
Top soil	2	0
Brown Clay	36	38
Blue Shale	30	68
Brown Sand	25	93
Cement Gravel	4	97
Brown Sand	11	108
Sand and Gravel (Water)	32	140

If log of well is not available, give name and address of driller. Willamette Drilling Co.

11. **Infiltration Trench:** Covered or open

Dimensions: Length ft. Minimum depth ft. Maximum depth ft.
 Bottom width ft. Discharge g.p.m. Date of test

12. **Tunnel:** Type of lining

Dimensions:
(Length, course, and cross sectional size)
 Position of water bearing stratum with reference to portal of tunnel

Log of tunnel: (Preceding table for log of well may be used, if desired. Give footage from portal and character of materials, as pertinent.)

13. **Pumping Equipment:**

(a) Pump 1 1/2" turbine - Jacuzzi Capacity 200 g.p.m.
(Make, type and size)


(b) Motor 10 hp 3 phase electric
(Type and horsepower)

14. **Location of area irrigated or to be irrigated, or place of use if for purposes other than irrigation.**

Township North or South	Range E. or W. of Willamette Meridian	Section	Forty-acre Tract	Number Acres To Be Irrigated	Date of Reclamation
6 S	2 W	24	SE 1/4 of the SE 1/4	27	June 1955

15. If the ground water supply is supplemental to an existing water supply, identification of any application for a permit, permit, certificate or adjudicated right to appropriate water made or held by the registrant.

Township 65 Range 2W, W.M.
North

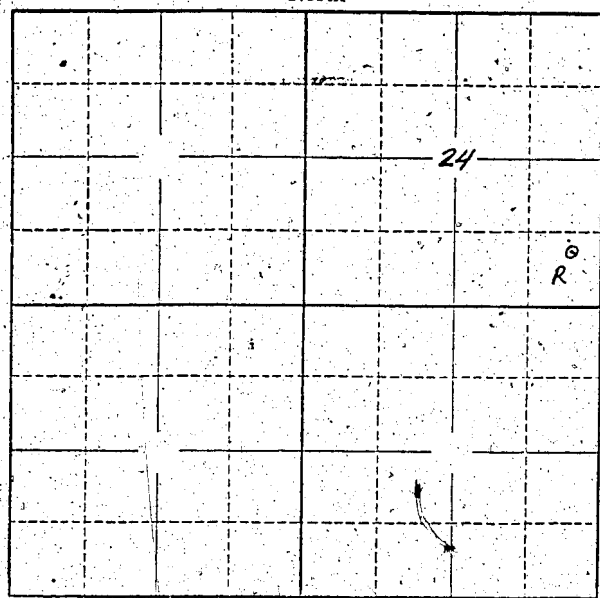

Locate well and acreage of irrigated land on plat.
Scale: 2" = 1 Mile

STATE OF OREGON

County of Marion } ss.

I, _____, being first duly sworn, do hereby certify that I have read the foregoing Registration Statement and that all of the items therein contained are true to the best of my knowledge and belief.

Lucy Lunn

(Signature of Registrant)

Subscribed and sworn to before me this 29 day of July, 1958

My commission expires 1-22-1962

James R. Lott

(Notary Public)

(SEAL)

CERTIFICATE OF REGISTRATION

STATE OF OREGON

County of Marion } ss.

This is to certify that the foregoing Registration Statement was received in the office of the State Engineer on the 30th day of July, 1958, at 3:10 o'clock P. M. and has been duly recorded in said office in Book No. 13 of Registration Statements on page GR-3042

Witness my hand this 8th day of June, 1959

Lucas A. Stanley

(State Engineer)

By _____

(Deputy)

\$15.00