

# Registration Statement

## OF CLAIMANT OF RIGHT TO APPROPRIATE GROUND WATER

TO THE STATE ENGINEER OF OREGON:

I, Charles F. & Leona C. Pelland

of Star Route Box 19, St. Paul County of Marion

(Mailing address)

State of Oregon, do hereby make application for a certificate of registration as evidence of a right to appropriate ground water.

1. Source from which water is withdrawn is Pump Well

(Flowing well, pump well, infiltration trench, or tunnel)

2. Location is: two and one half miles South of St. Paul, Oregon

(Approximate distance and direction from nearest city or town)

and is more particularly described as follows:

(a) 21 1/2 Chain W. & 1/2 chain N. from S. E. corner Section 36

(Give distance and bearing to corner of section or other legal subdivision)

being within S. W. 1/4 S. E. 1/4 of Sec. 36, Twp. 4 S, Rge. 3 W

(Smallest legal subdivision)

(N. or S.)

(E. or W.)

or (b) within limits of recorded platted property, town or city:

in Lot \_\_\_\_\_, Block \_\_\_\_\_ of \_\_\_\_\_

(Name of plat or addition)

County of \_\_\_\_\_

(If within city or town, give name)

3. Construction Work was begun on October 1949; was completed on November 1949

(Date)

(Date)

and the ground water claimed was first used for the purposes set out below on 1950

(Date)

since which time the water has been used Continuously

(Continuously or intermittently)

from 1950 to 1958

(Date)

(Date)

4. Quantity of water claimed and used is 575 gallons per minute; \_\_\_\_\_ acre feet per year.

5. Purpose or Purposes for which water is used Irrigation

(Domestic, irrigation, municipal, manufacturing, industrial, etc.)

6. Description of Well: Depth 251 feet. Type Drilled

(Dug or drilled)

diameter 10 inches. Elevation of ground at well site about 150 feet, mean sea level.

(As near as known)

Depth to water table 31 feet.

7. Capacity of Well: 575 g.p.m. with 124 feet drawdown.

\_\_\_\_\_ g.p.m. with \_\_\_\_\_ feet drawdown.

Date of test November 1949

If Flowing Well: Measured discharge \_\_\_\_\_ g.p.m. on \_\_\_\_\_

(Date)

Shut-in pressure at ground surface \_\_\_\_\_ lbs. per sq. in. on \_\_\_\_\_

(Date)

Water is controlled by \_\_\_\_\_

(Cap, valve, etc.)

8. Casing: (Give diameter, commercial specifications and depth below ground surface of each casing size.)

10 inch diameter ..... from 0 to 244 feet  
 ..... inch diameter ..... from ..... to ..... feet  
 ..... inch diameter ..... from ..... to ..... feet  
 ..... inch diameter ..... from ..... to ..... feet

Describe and show depth of shoe, plug, adapter, liner or other details: .....

9. Perforated Casings or Screens:


none ..... from ..... to .....  
 (Number per foot and size of perforations, or describe screen)  
 ..... from ..... to .....  
 ..... from ..... to .....  
 ..... from ..... to .....

10. Log of Well: (Describe each stratum or formation clearly, indicate if water bearing, and give thickness and depth as indicated.)

MATERIAL	Thickness (Feet)	Depth to Bottom (Feet)
0/ 23 Ft. Surface clay & sand	0/	23
Surface sand & water	23	27
Gray clay	27	63
Green clay with sand streaks	63	73
Blue clay	73	83
Course black sand & gravel (tested 100 gal. P.M.)	83	91
Soft clay	91	100
Broken sand & clay - soft & muddy	100	116
Soft clay - gray	116	135
Soft fine sand	135	142
Sandy clay	142	165
Gray sand - little water	165	174
Gray clay	174	195
Yellow clay	195	208
Blue clay	208	224
Gray sandy clay with white rock - hard	224	237
Blue clay	237	243
Clay & sand - broken	243	245
Course black sand & gravel (water) T. D.	245	251



Township 4S Range 3W W.M.  
North

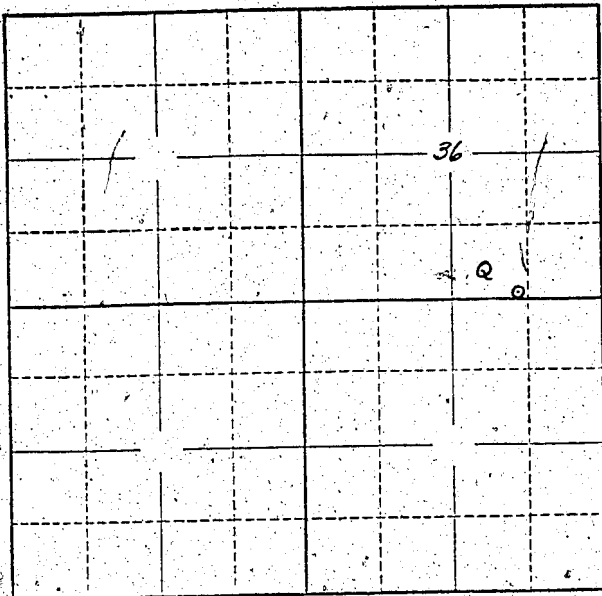

Locate well and acreage of irrigated land on plat.  
Scale: 2" = 1 Mile

STATE OF OREGON

County of Marion } ss.

I, Charles F. Pelland, being first duly sworn, do hereby certify that I have read the foregoing Registration Statement and that all of the items therein contained are true to the best of my knowledge and belief.

Charles F. Pelland  
(Signature of Registrant)

Subscribed and sworn to before me this 30th day of July, 1958

My commission expires May 25 1959

Robert Lewis  
(Notary Public)

(SEAL)

**CERTIFICATE OF REGISTRATION**

STATE OF OREGON

County of Marion } ss.

This is to certify that the foregoing Registration Statement was received in the office of the State Engineer on the 31st day of July, 1958, at 3:00 o'clock P. M. and has been duly recorded in said office in Book No. 13 of Registration Statements on page GR-3044

Witness my hand this 8th day of June, 1959

Laura A. Standley  
(State Engineer)

By \_\_\_\_\_ (Deputy)

# 26.10

GR - 3044