

Registration Statement

OF CLAIMANT OF RIGHT TO APPROPRIATE GROUND WATER

TO THE STATE ENGINEER OF OREGON:

I, Ellis M. Kropf

of Hubbard County of Clackamas

(Mailing address)

State of Oregon, do hereby make application for a certificate of registration as evidence of a right to appropriate ground water.

1. Source from which water is withdrawn is pump-well
(Flowing well, pump well, infiltration trench, or tunnel)

2. Location is: 4 miles east of Hubbard
(Approximate distance and direction from nearest city or town)

and is more particularly described as follows:

(a) 300 feet North & 25 feet east from NW 1/4 corner Section 6
(Give distance and bearing to corner of section or other legal subdivision)

being within SW 1/4 of NW 1/4 of Sec. 6, Twp. T5S, Rge. R1E
(Smallest legal subdivision) (N. or S.) (E. or W.)

or (b) within limits of recorded platted property, town or city:

in Lot _____, Block _____ of _____
(Name of plat or addition)

County of _____
(If within city or town, give name)

3. Construction Work was begun on Aug. 1951; was completed on Aug. 1951
(Date) (Date)

and the ground water claimed was first used for the purposes set out below on Aug. 1951
(Date)

since which time the water has been used intermittent during season
(Continuously or intermittently)

from Aug. 1951 to Oct. 1957
(Date) (Date)

4. Quantity of water claimed and used is 50 gallons per minute; _____ acre feet per year.

5. Purpose or Purposes for which water is used irrigation

(Domestic, irrigation, municipal, manufacturing, industrial, etc.)

6. Description of Well: Depth 115 feet. Type drilled
(Dug or drilled)

diameter 6 inches. Elevation of ground at well site 100 feet, mean sea level.
(As near as known)

Depth to water table 48 feet.

7. Capacity of Well: 105 g.p.m. with 57 feet drawdown.

_____ g.p.m. with _____ feet drawdown.

Date of test Aug. 1951

If Flowing Well: Measured discharge _____ g.p.m. on _____
(Date)

Shut-in pressure at ground surface _____ lbs. per sq. in. on _____
(Date)

Water is controlled by _____
(Cap, valve, etc.)

8. Casing: (Give diameter, commercial specifications and depth below ground surface of each casing size.)

6 inch diameter steel casing from 0 to 115 feet
 inch diameter from 0 to feet
 inch diameter from to feet
 inch diameter from to feet

Describe and show depth of shoe, plug, adapter, liner or other details:

9. Perforated Casings or Screens:

5 per foot per row 4 rows 1/2x 3/4 from 106 to 112
 (Number per foot and size of perforations, or describe screen)
 from to
 from to
 from to

10. Log of Well: (Describe each stratum or formation clearly, indicate if water bearing, and give thickness and depth as indicated.)

MATERIAL	Thickness (Feet)	Depth to Bottom (Feet)
top soil	10	10
silt & water	10	20
blue clay	13	33
soft blue clay	2	35
blue clay (stickey)	14	49
dark silt (lots of wood)	4	53
blue clay	32	85
dark brown sand (fine)	5	90
mixed colors of clay	4	94
dark sand (fine)	10	104
sand & gravel	8	112
blue clay	3	115

If log of well is not available, give name and address of driller. J. Beck

11. Infiltration Trench: Covered or open

Dimensions: Length ft. Minimum depth ft. Maximum depth ft.

Bottom width ft. Discharge g.p.m. Date of test

12. Tunnel: Type of lining

Dimensions: (Length, course, and cross sectional size)

Position of water bearing stratum with reference to portal of tunnel

Log of tunnel: (Preceding table for log of well may be used, if desired. Give footage from portal and character of materials, as pertinent.)

13. Pumping Equipment:

(a) Pump ~~Peerless~~ Peerless Turbine Capacity 85 g.p.m.
(Make, type and size)


(b) Motor 5 H.P.
(Type and horsepower)

14. Location of area irrigated or to be irrigated, or place of use if for purposes other than irrigation.

Township North or South	Range E. or W. of Willamette Meridian	Section	Forty-acre Tract	Number Acres To Be Irrigated	Date of Reclamation
T5S	R1E	6	SW 1/4 of NW 1/4	9.5	1951
"	R1W	1	SE 1/4 of NE 1/4	7.0	1951
				16.5	"

15. If the ground water supply is supplemental to an existing water supply, identification of any application for a permit, permit, certificate or adjudicated right to appropriate water made or held by the registrant.

Township 55 Range 1E, W.M.
North

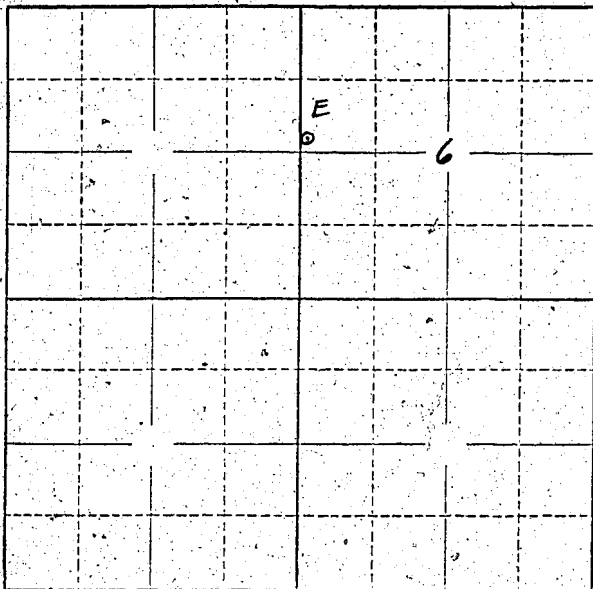

Locate well and acreage of irrigated land on plat.
Scale: 2" = 1 Mile

STATE OF OREGON

County of Marion } ss.

I, Ellis Kroft, being first duly sworn, do hereby certify that I have read the foregoing Registration Statement and that all of the items therein contained are true to the best of my knowledge and belief.

Ellis Kroft
(Signature of Registrant)

Subscribed and sworn to before me this 30th day of July, 1958

My commission expires 12th June 1961 Wm. D. Baitholmeis
(Notary Public)

(SEAL)

CERTIFICATE OF REGISTRATION

STATE OF OREGON

County of Marion } ss.

This is to certify that the foregoing Registration Statement was received in the office of the State Engineer on the 30th day of July, 1958, at 4:00 o'clock P. M. and has been duly recorded in said office in Book No. 13 of Registration Statements on page GR 3046

Witness my hand this 8th day of June, 1959

Leura A. Stanley
(State Engineer)

By _____ (Deputy)

\$ 15.00