

Registration Statement

OF CLAIMANT OF RIGHT TO APPROPRIATE GROUND WATER

TO THE STATE ENGINEER OF OREGON:

I, E.W. Hewett

of 1386 W 13th Eugene Ore County of Marion

State of Oregon do hereby make application for a certificate of registration as evidence of a right to appropriate ground water.

1. Source from which water is withdrawn is well (Flowing well, pump well, infiltration trench, or tunnel)

2. Location is: 2 miles south east of Independence, Oregon (Approximate distance and direction from nearest city or town)

and is more particularly described as follows:

(a) 190 feet west of the SE corner of the NW 1/4 section 33 then 260 feet north (Give distance and bearing to corner of section or other legal subdivision)
being within 31.8 acres SE 1/4 NE 1/4 of Sec. 34, Twp. 8 S, Rge. 4 W (Smallest legal subdivision) (N. or S.) (E. or W.)

or (b) within limits of recorded platted property, town or city:

in Lot _____, Block _____ of _____ (Name of plat or addition)

County of Marion (If within city or town, give name)

3. Construction Work was begun on 3/10/55 (Date), was completed on same 1955 (Date)

and the ground water claimed was first used for the purposes set out below on Unknown 1955 (Date)

since which time the water has been used intermittently (Continuously or intermittently)

from 1955 (Date) to Oct. 1957 (Date)

4. Quantity of water claimed and used is 320 gallons per minute; same acre feet per year.

5. Purpose or Purposes for which water is used Irrigation

(Domestic, irrigation, municipal, manufacturing, industrial, etc.)

6. Description of Well: Depth 44 feet. Type Drilled (Dug or drilled)

diameter 8 inches. Elevation of ground at well site 121 feet, mean sea level. (As near as known)

Depth to water table 17 feet.

7. Capacity of Well: _____ g.p.m. with _____ feet drawdown.

_____ g.p.m. with _____ feet drawdown.

Date of test _____

If Flowing Well: Measured discharge _____ g.p.m. on _____ (Date)

Shut-in pressure at ground surface _____ lbs. per sq. in. on _____ (Date)

Water is controlled by _____ (Cap, valve, etc.)

8. Casing: (Give diameter, commercial specifications and depth below ground surface of each casing size.)

..... inch diameter from to feet
 .8..... inch diameter from 0 to 44 feet
 inch diameter from to feet
 inch diameter from to feet

Describe and show depth of shoe, plug, adapter, liner or other details:

.....

.....


9. Perforated Casings or Screens:

Unknown from to
 (Number per foot and size of perforations, or describe screen)
 from to
 from to
 from to

10. Log of Well: (Describe each stratum or formation clearly, indicate if water bearing, and give thickness and depth as indicated.)

MATERIAL	Thickness (Feet)	Depth to Bottom (Feet)
UNKNOWN		

Township 8S Range 4W, W.M.
North

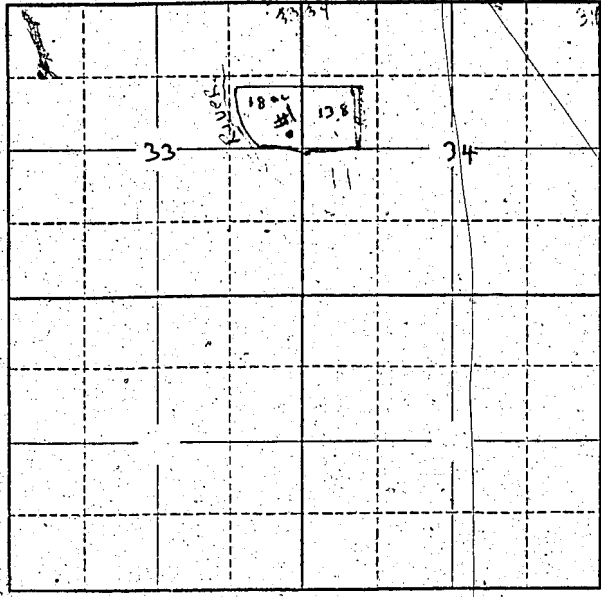

Locate well and acreage of irrigated land on plat.
Scale: 2" = 1 Mile

STATE OF OREGON }
County of Marion } ss.

I, Engie W. Hewitt, being first duly sworn, do hereby certify that I have read the foregoing Registration Statement and that all of the items therein contained are true to the best of my knowledge and belief.

Engie W. Hewitt
(Signature of Registrant)

Subscribed and sworn to before me this 30th day of July, 1958

My commission expires 12th June 1961 Wm. S. Bartholomew
(Notary Public)

(SEAL)

CERTIFICATE OF REGISTRATION

STATE OF OREGON }
County of Marion } ss.

This is to certify that the foregoing Registration Statement was received in the office of the State Engineer on the 30th day of July, 1958, at 4:15 o'clock P. M. and has been duly recorded in said office in Book No. 13 of Registration Statements on page GR-3048

Witness my hand this 8th day of June, 1959

Lura A. Stanley
(State Engineer)

\$15.30

By _____
(Deputy)