

Registration No. GR 3281

Certificate No. GR 3050

Registration Statement

OF CLAIMANT OF RIGHT TO APPROPRIATE GROUND WATER

TO THE STATE ENGINEER OF OREGON:

I, E. W. Hewett

of ~~Englewood~~ 1386 W 13th Eugene County of Marion

State of Oregon, do hereby make application for a certificate of registration as evidence of a right to appropriate ground water.

1. Source from which water is withdrawn is Well #3
(Flowing well, pump well, infiltration trench, or tunnel)

2. Location is: 2 miles south east of Independence, Oregon
(Approximate distance and direction from nearest city or town)

and is more particularly described as follows:

(a) 1560 feet west and 568 feet south of the center of section 34
(Give distance and bearing to corner of section or other legal subdivision)

being within 26.4 NW 1/4 SW 1/4 of Sec. 34, Twp. 8 S, Rge. 4 W
(Smallest legal subdivision) (N. or S.) (E. or W.)

or (b) within limits of recorded platted property, town or city:

in Lot _____, Block _____ of _____
(Name of plat or addition)

County of Marion

(If within city or town, give name)

3. Construction Work was begun on Unknown; was completed on 1955
(Date) (Date)

and the ground water claimed was first used for the purposes set out below on Unknown 1955
(Date)

since which time the water has been used intermitently
(Continuously or Intermittently)

from 1955 to Oct. 1957
(Date) (Date)

4. Quantity of water claimed and used is 260 gallons per minute; _____ acre feet per year.

5. Purpose or Purposes for which water is used Irrigation

(Domestic, irrigation, municipal, manufacturing, industrial, etc.)

6. Description of Well: Depth 46 feet. Type drilled
(Dug or drilled)

diameter 8 inches. Elevation of ground at well site 121 feet, mean sea level.
(As near as known)

Depth to water table 16 feet.

7. Capacity of Well: unknown g.p.m. with unknown feet drawdown.

_____ g.p.m. with _____ feet drawdown.

Date of test _____

If Flowing Well: Measured discharge _____ g.p.m. on _____

(Date)

Shut-in pressure at ground surface _____ lbs. per sq. in. on _____

(Date)

Water is controlled by _____

(Cap. valve, etc.)

8. Casing: (Give diameter, commercial specifications and depth below ground surface of each casing size.)

8 inch diameter from 0 to 46 feet
 inch diameter from to feet
 inch diameter from to feet
 inch diameter from to feet

Describe and show depth of shoe, plug, adapter, liner or other details:

9. Perforated Casings or Screens:

Unknown from to
(Number per foot and size of perforations, or describe screen)
 from to
 from to
 from to

10. Log of Well: (Describe each stratum or formation clearly, indicate if water bearing, and give thickness and depth as indicated.)

| MATERIAL | Thickness (Feet) | Depth to Bottom (Feet) |
|----------|------------------|------------------------|
| UNKNOWN | | |
| | | |
| | | |
If log of well is not available, give name and address of driller.....

11. Infiltration Trench: Covered or open

Dimensions: Length ft. Minimum depth ft. Maximum depth ft.

Bottom width ft. Discharge g.p.m. Date of test

12. Tunnel: Type of lining

Dimensions: (G.P., course, and cross sectional size)

Position of water bearing stratum with reference to portal of tunnel

Log of tunnel: (Preceding table for log of well may be used, if desired. Give footage from portal and character of materials, as pertinent.)

13. Pumping Equipment:

(a) Pump Capacity 320 g.p.m.
(Make, type and size)


(b) Motor Ford Stationary
(Type and horsepower)

14. Location of area irrigated or to be irrigated, or place of use if for purposes other than irrigation.

| Township North or South | Range E. or W. of Willamette Meridian | Section | Forty-acre Tract | Number Acres To Be Irrigated | Date of Reclamation |
|-------------------------|---------------------------------------|---------|---------------------------------|------------------------------|---------------------|
| 8 South | 4 West | 34 | SW 1/4 NW 1/4 SW 1/4 | 15 25.4 | 1955 |
| " | " | " | NE 1/4 SW 1/4 | 15 | " |
| | | | | <u>30.0 Ac</u> | " |
| | | | | | |
| | | | | | |
15. If the ground water supply is supplemental to an existing water supply, identification of any application for a permit, permit, certificate or adjudicated right to appropriate water made or held by the registrant.

Township 8 S Range 4 W, W.M.
North

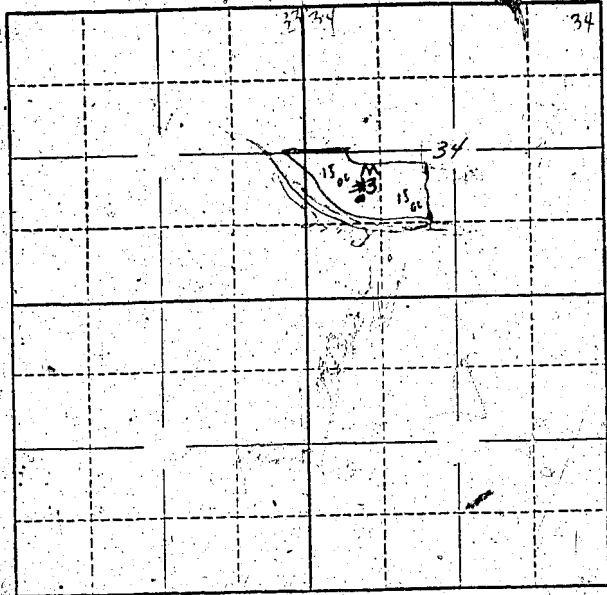

Locate well and acreage of irrigated land on plat.
Scale: 2" = 1 Mile

STATE OF OREGON }
County of Marion } ss.

I, Eugene W. Heinert, being first duly sworn, do hereby certify that I have read the foregoing Registration Statement and that all of the items therein contained are true to the best of my knowledge and belief.

Eugene W. Heinert
(Signature of Registrant)

Subscribed and sworn to before me this 30th day of July, 1958

My Commission expires 12th June 1961

Wm. S. Bartholomew
(Notary Public)

(SEAL)

CERTIFICATE OF REGISTRATION

STATE OF OREGON }
County of Marion } ss.

This is to certify that the foregoing Registration Statement was received in the office of the State Engineer on the 30th day of July, 1958, at 4:15 o'clock P. M. and has been duly recorded in said office in Book No. 13 of Registration Statements on page GR-3050

Witness my hand this 8th day of June, 1959

Laura A. Stanley
(State Engineer)

By _____
(Deputy)

#1522