

Registration Statement

REGISTRATION NO. GR-3284CERTIFICATE NO. GR-3053

OF CLAIMANT OF RIGHT TO APPROPRIATE GROUND WATER

(Under Chapter 708, Oregon Laws 1955.)

TO THE STATE ENGINEER OF OREGON:

I, W Leo Schrammick
of Dayton County of Hamhill
State of Oregon, do hereby make application for a certificate of registration as evidence
of a right to appropriate ground water.

1. Source from which water is withdrawn is Pump well
(Flowing well, pump well, infiltration trench, or tunnel)
2. Location is: Six miles south of Dayton
(Approximate distance and direction from nearest city or town)

and is more particularly described as follows:

(a) 550 feet North & 200 feet east from Center Section 8
(Give distance and bearing to corner of section or other legal subdivision)

being within S.E. 1/4 N.E. 1/4 of Sec. 8, Twp. 5 S., Rge. 3 W.
(Smallest legal subdivision) (N. or S.) (E. or W.)

or (b) within limits of recorded platted property, town or city:

in Lot _____, Block _____ of _____
(Name of plat or addition)

County of Hamhill
(If within city or town, give name)

3. Construction Work was begun on 1941; was completed on 1941
(Date) (Date)

and the ground water claimed was first used for the purposes set out below on Early 20 days 1941
(Date)since which time the water has been used intermittently during season
(Continuously or intermittently)from 1941 to Oct 1957
(Date) (Date)

4. Quantity of water claimed and used is 20 gallons per minute; _____ acre
feet per year.

5. Purpose or Purposes for which water is used for ~~house use~~ and
irrigation
(Domestic, irrigation, municipal, manufacturing, industrial, etc.)

6. Description of Well: Depth 37 1/2 feet. Type drilled
(Dug or drilled)

diameter 10 inches inches. Elevation of ground at well site _____ feet, mean sea level.
(As near as known)

Depth to water table 24 feet.

7. Capacity of Well: 2 sprinklers all day g.p.m. with 18 inches feet drawdown.
_____ g.p.m. with _____ feet drawdown.

Date of test July 29, 1958If Flowing Well: Measured discharge _____ g.p.m. on _____
(Date)Shut-in pressure at ground surface _____ lbs. per sq. in. on _____
(Date)Water is controlled by _____
(Cap, valve, etc.)

8. Casing: (Give diameter, commercial specifications and depth below ground surface of each casing size.)

12 inch diameter *Concrete* from *0* to *3 1/2* feet
 inch diameter from to feet
 inch diameter from to feet
 inch diameter from to feet

Describe and show depth of shoe, plug, adapter, liner or other details:

9. Perforated Casings or Screens:

NO (Number per foot and size of perforations, or describe screen) from to
 from to
 from to
 from to

10. Log of Well: (Describe each stratum or formation clearly, indicate if water bearing, and give thickness and depth as indicated.)

MATERIAL	Thickness (Feet)	Depth to Bottom (Feet)
<i>Sand & gravel</i>		

If log of well is not available, give name and address of driller.

11. Infiltration Trench: Covered or open
Dimensions: Length ft. Minimum depth ft. Maximum depth ft.
Bottom width ft. Discharge g.p.m. Date of test

12. Tunnel: Type of lining
Dimensions:
(Length, course, and cross sectional size)
Position of water bearing stratum with reference to portal of tunnel

Log of tunnel: (Preceding table for log of well may be used, if desired. Give footage from portal and character of materials, as pertinent.)


13. Pumping Equipment:
(a) Pump *Starbanks-Morse* Capacity *20* g.p.m.
(b) Motor *1/4 horsepower*
(Type and horsepower)

14. Location of area irrigated or to be irrigated, or place of use if for purposes other than irrigation.

Township North or South	Range E. or W. of Willamette Meridian	Section	Forty-acre Tract	Number Acres To Be Irrigated	Date of Reclamation
<i>5 S</i>	<i>3 W</i>	<i>8</i>	<i>S.W. 1/4 N.E. 1/4</i>	<i>4 acres</i>	<i>1941</i>

15. If the ground water supply is supplemental to an existing water supply, identification of any application for a permit, permit, certificate or adjudicated right to appropriate water made or held by the registrant.

Township 5 S Range 3 W W.M.
North

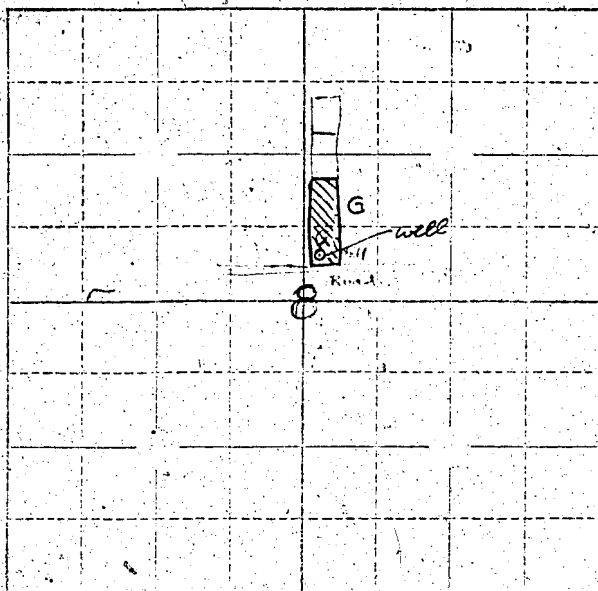

Locate well and acreage of irrigated land on plat.

Scale: $\frac{1}{4}$ " = 1 Mile

STATE OF OREGON

County of Marion ss.

I, H. Leo Schrammick being first duly sworn, do hereby certify that I have read the foregoing Registration Statement and that all of the items therein contained are true to the best of my knowledge and belief.

H. Leo Schrammick
(Signature of Registrant)

Subscribed and sworn to before me this 30th day of July 19 58

My commission expires 12th June 1961

Wm. S. Bartholomew
(Notary Public)

(SEAL)

CERTIFICATE OF REGISTRATION

STATE OF OREGON

County of Marion } ss.

This is to certify that the foregoing Registration Statement was received in the office of the State Engineer on the 30th day of July, 19 58, at 4:45 o'clock P. M. and has been duly recorded in said office in Book No. 13 of Registration Statements on page GR-3053

Witness my hand this 8th day of June, 19 59

Wm. A. Stines
(State Engineer)

By _____ (Deputy)

GR-3053

\$15.00