

# Registration Statement

## OF CLAIMANT OF RIGHT TO APPROPRIATE GROUND WATER

TO THE STATE ENGINEER OF OREGON:

I, Everett E. & Octava C. Goin

of Rt. 1 Jefferson County of Marion

State of Oregon do hereby make application for a certificate of registration as evidence of a right to appropriate ground water.

1. Source from which water is withdrawn is Pump well  
(Flowing well, pump well, infiltration trench, or tunnel)

2. Location is: 2 miles S.E. of Jefferson  
(Approximate distance and direction from nearest city or town)

and is more particularly described as follows:

(a) 1518' E. & 363' N from SW corner Section 7  
(Give distance and bearing to corner of section or other legal subdivision)

being within S.E. 1/4 SW 1/4 of Sec. 7, Twp. 10 S, Rge. 2 W  
(Smallest legal subdivision) (N. or S.) (E. or W.)

or (b) within limits of recorded platted property, town or city:

in Lot \_\_\_\_\_, Block \_\_\_\_\_ of \_\_\_\_\_  
(Name of plat or addition)

County of \_\_\_\_\_  
(If within city or town, give name)

3. Construction Work was begun on April 1940; was completed on April 1940  
(Date) (Date)

and the ground water claimed was first used for the purposes set out below on Don't know April 1940  
(Date)

since which time the water has been used intermittently  
(Continuously or intermittently)

from April 1940 to present  
(Date) (Date)

4. Quantity of water claimed and used is 2.56 gallons per minute; 32.5 acre feet per year.

5. Purpose or Purposes for which water is used Irrigation

(Domestic, irrigation, municipal, manufacturing, industrial, etc.)

6. Description of Well: Depth 26 feet. Type Driven Drilled  
(Dug or drilled)

diameter 8 inches. Elevation of ground at well site 2.45 feet, mean sea level.  
(As near as known)

Depth to water table 10 feet.

7. Capacity of Well: Don't know g.p.m. with \_\_\_\_\_ feet drawdown.

\_\_\_\_\_ g.p.m. with \_\_\_\_\_ feet drawdown.

Date of test \_\_\_\_\_

If Flowing Well: Measured discharge \_\_\_\_\_ g.p.m. on \_\_\_\_\_  
(Date)

Shut-in pressure at ground surface \_\_\_\_\_ lbs. per sq. in. on \_\_\_\_\_  
(Date)

Water is controlled by \_\_\_\_\_  
(Cap, valve, etc.)

8. Casing: (Give diameter, commercial specifications and depth below ground surface of each casing size.)

8 inch diameter *steel well casing* from 0 to 26 feet  
 inch diameter from to feet  
 inch diameter from to feet  
 inch diameter from to feet

Describe and show depth of shoe, plug, adapter, liner or other details:

9. Perforated Casings or Screens:

*Don't know* from to  
 (Number per foot and size of perforations, or describe screen)  
 from to  
 from to  
 from to

10. Log of Well: (Describe each stratum or formation clearly, indicate if water bearing, and give thickness and depth as indicated.)

MATERIAL	Thickness (Feet)	Depth to Bottom (Feet)
<i>Not available</i>		

If log of well is not available, give name and address of driller. *Don't know*

11. Infiltration Trench: Covered or open .....  
 Dimensions: Length ..... ft. Minimum depth ..... ft. Maximum depth ..... ft.  
 Bottom width ..... ft. Discharge ..... g.p.m. Date of test .....

12. Tunnel: Type of lining .....  
 Dimensions: .....  
(Length, course, and cross sectional size)  
 Position of water bearing stratum with reference to portal of tunnel .....

Log of tunnel: (Preceding table for log of well may be used, if desired. Give footage from portal and character of materials, as pertinent.)

13. Pumping Equipment:  
 (a) Pump ..... *2" centrifugal* ..... Capacity *256* g.p.m.  
(Make, type and size)  
 (b) Motor ..... *10HP 3 phase electric* .....  
(Type and horsepower)


14. Location of area irrigated or to be irrigated, or place of use if for purposes other than irrigation.

Township North or South	Range E. or W. of Willamette Meridian	Section	Forty-acre Tract	Number Acres To Be Irrigated	Date of Reclamation
<i>10 S</i>	<i>2 W</i>	<i>7</i>	<i>SW 1/4 of SW 1/4</i>	<i>3.0</i>	<i>1940</i>
"	"	"	<i>SE 1/4 of SW 1/4</i>	<i>10.3</i>	<i>1940</i>

15. If the ground water supply is supplemental to an existing water supply, identification of any application for a permit, permit, certificate or adjudicated right to appropriate water made or held by the registrant.

*None*

Township 10S Range 2W W.M.  
North

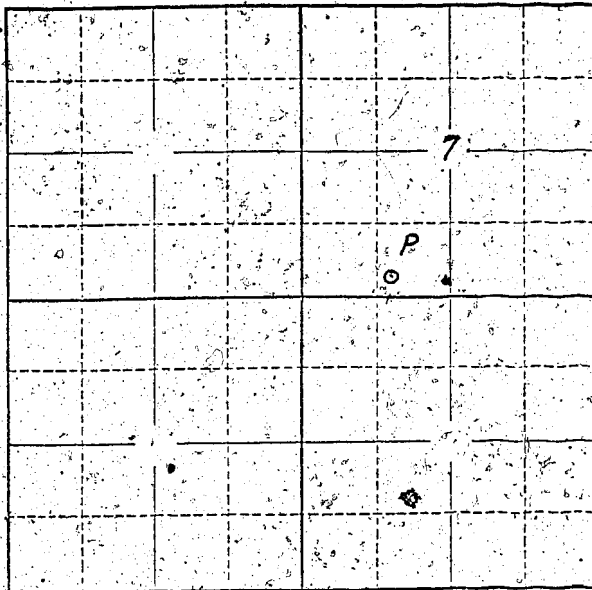

Locate well and acreage of irrigated land on plat.  
Scale: 2" = 1 Mile

STATE OF OREGON

County of Marion } ss.

I, Ernest E. Guin Ostrom Don, being first duly sworn, do hereby certify that I have read the foregoing Registration Statement and that all of the items therein contained are true to the best of my knowledge and belief.

Ernest E. Guin Ostrom Don  
(Signature of Registrant)

Subscribed and sworn to before me this 31 day of July, 1958.

My commission expires

NOTARY PUBLIC  
My Comm. Expires April 19, 1960

Frank B. Suttler  
(Notary Public)

(SEAL)

CERTIFICATE OF REGISTRATION

STATE OF OREGON

County of Marion } ss.

This is to certify that the foregoing Registration Statement was received in the office of the State Engineer on the 31st day of July, 1958, at 9:15 o'clock A. M. and has been duly recorded in said office in Book No. 13 of Registration Statements on page GR-3055

Witness my hand this 8th day of June, 1959

Lewis A. Atkinson  
(State Engineer)

By \_\_\_\_\_ (Deputy)

GR - 3055

1500