

Registration Statement

OF CLAIMANT OF RIGHT TO APPROPRIATE GROUND WATER

TO THE STATE ENGINEER OF OREGON:

I, CLAYTON E. AND DORIS L. HEATON

of Route 2, Box 536 - Troutdale (Mailing address) County of Multnomah

State of OREGON, do hereby make application for a certificate of registration as evidence of a right to appropriate ground water.

1. Source from which water is withdrawn is Pump Well (Flowing well, pump well, infiltration trench, or tunnel)

2. Location is: 3 miles west of Troutdale on N.E. Halsey (Approximate distance and direction from nearest city or town)

and is more particularly described as follows:

(a) S. 55° 00' E. NW cor. Sec. 32 1500' (Give distance and bearing to corner of section or other legal subdivision)
being within NW 1/4 NW 1/4 of Sec. 32, Twp. 1 N, Rge. 3 E (Smallest legal subdivision) (N. or S.) (E. or W.)

or (b) within limits of recorded platted property, town or city:

in Lot, Block of (Name of plat or addition)

County of (If within city or town, give name)

3. Construction Work was begun on June 1, 1950 (Date); was completed on July 1, 1950 (Date)

and the ground water claimed was first used for the purposes set out below on July 1, 1950 (Date)

since which time the water has been used CONTINUOUSLY (Continuously or intermittently)

from July 1, 1950 (Date) to July 25, 1958 (Date)

4. Quantity of water claimed and used is 120 gallons per minute; acre feet per year.

5. Purpose or Purposes for which water is used IRRIGATION

(Domestic, irrigation, municipal, manufacturing, industrial, etc.)

6. Description of Well: Depth 180 feet. Type DRILLED (Dug or drilled)

diameter 8 inches. Elevation of ground at well site 235 feet, mean sea level. (As near as known)

Depth to water table 30 feet.

7. Capacity of Well: 120 g.p.m. with feet drawdown.

1 g.p.m. with feet drawdown.

Date of test July 1, 1950

If Flowing Well: Measured discharge g.p.m. on (Date)

Shut-in pressure at ground surface lbs. per sq. in. on (Date)

Water is controlled by (Cap, valve, etc.)

8. **Casing:** (Give diameter, commercial specifications and depth below ground surface of each casing size.)

8 inch diameter PIPE from SURFACE to 180 feet

inch diameter from to feet

inch diameter from to feet

inch diameter from Y to feet

Describe and show depth of shoe, plug, adapter, liner or other details:

9. Perforated Casings or Screens:

UNKNOWN

(Number per foot and size of perforations, or describe screen)

from to

from to

from to

from to

10. **Log of Well:** (Describe each stratum or formation clearly, indicate if water bearing, and give thickness and depth as indicated.)

[illegible]

11544 NE. GLISAN - PORTLAND, OREGON

Dimensions: Length ft. Minimum depth ft. Maximum depth ft.
Bottom width ft. Discharge g.p.m. Date of test


Position of water bearing stratum with reference to portal of tunnel

(b) Motor G.F. MOTOR - 10 HORSEPOWER
(Type and horsepower)

[illegible]

GR. 3057

Township 1N Range 3E W.M.
North

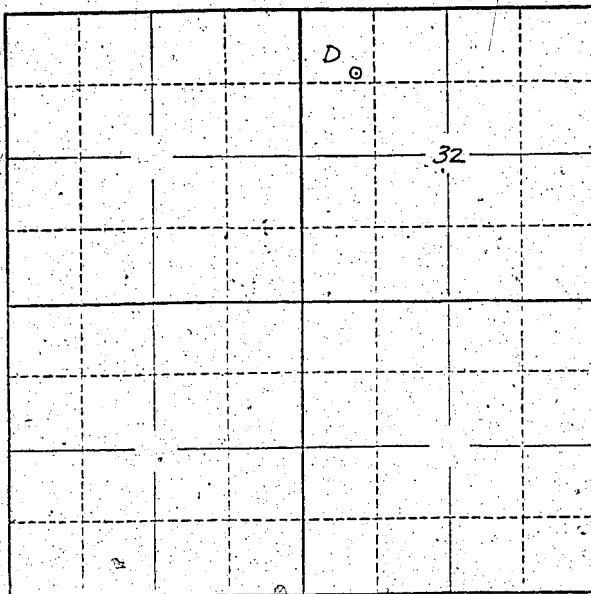

Locate well and acreage of irrigated land on plat.
Scale: 2" = 1 Mile

STATE OF OREGON

County of Multnomah

I, Clayton E. Heaton and Doris L., being ^{each} first duly sworn, do hereby certify that I have read the foregoing Registration Statement and that all of the items therein contained are true to the best of my knowledge and belief.

Heaton, his wife,

Clayton E. Heaton
Doris L. Heaton

(Signature of Registrant)

Subscribed and sworn to before me this 26th day of July, 1958.

My commission expires 4/17/59

(SEAL)

Charles M. Reagan
(Notary Public)

CERTIFICATE OF REGISTRATION

STATE OF OREGON

County of Marion

This is to certify that the foregoing Registration Statement was received in the office of the State Engineer on the 28th day of July, 1958, at 2:00 o'clock A. M. and has been duly recorded in said office in Book No. 13 of Registration Statements on page GR-3057

Witness my hand this 8th day of June, 1959

\$15.00

Lewis A. Stanley
(State Engineer)

By

(Deputy)

GR-3057