

# Registration Statement

## OF CLAIMANT OF RIGHT TO APPROPRIATE GROUND WATER

TO THE STATE ENGINEER OF OREGON:

I, Kirk Ross  
of St. Rt Newberg County of Martin  
(Mailing address)

State of Oregon, do hereby make application for a certificate of registration as evidence of a right to appropriate ground water.

1. Source from which water is withdrawn is pump well #2  
(Flowing well, pump well, infiltration trench, or tunnel)

2. Location is: 2 1/2 east of St Paul  
(Approximate distance and direction from nearest city or town)

and is more particularly described as follows:

(a) 1800 feet north & 600 feet east from SW Corner Section 22  
(Give distance and bearing to corner of section or other legal subdivision)

being within NW 1/4 of SW 1/4 of Sec. 22, Twp. 4 N, Rge. 2 W  
(Smallest legal subdivision) (N. or S.) (E. or W.)

or (b) within limits of recorded platted property, town or city:

in Lot \_\_\_\_\_, Block \_\_\_\_\_ of \_\_\_\_\_  
(Name of plat or addition)

County of \_\_\_\_\_  
(If within city or town, give name)

3. Construction Work was begun on July 15, 1955 was completed on Aug 2, 1955  
(Date) (Date)

and the ground water claimed was first used for the purposes set out below on Aug 2, 1955  
(Date)

since which time the water has been used for growing of crops continuously  
(Continuously or intermittently)

from Aug 2, 1955 to Oct 1957  
(Date) (Date)

4. Quantity of water claimed and used is 300 gallons per minute; 100 acre feet per year.

5. Purpose or Purposes for which water is used irrigation

(Domestic, irrigation, municipal, manufacturing, industrial, etc.)

6. Description of Well: Depth 117 feet. Type drilled  
(Dug or drilled)

diameter 18 inches. Elevation of ground at well site 150 feet, mean sea level.  
(As near as known)

Depth to water table 15 feet.

7. Capacity of Well: 350 g.p.m. with 50 feet drawdown.

\_\_\_\_\_ g.p.m. with \_\_\_\_\_ feet drawdown.

Date of test Aug 2, 1955

If Flowing Well: Measured discharge \_\_\_\_\_ g.p.m. on \_\_\_\_\_  
(Date)

Shut-in pressure at ground surface \_\_\_\_\_ lbs. per sq. in. on \_\_\_\_\_  
(Date)

Water is controlled by \_\_\_\_\_  
(Cap, valve, etc.)



If log of well is not available, give name and address of driller.

*J. T. Miller  
Astoria, Oregon*

11. Infiltration Trench: Covered or open

Dimensions: Length \_\_\_\_\_ ft. Minimum depth \_\_\_\_\_ ft. Maximum depth \_\_\_\_\_ ft.  
Bottom width \_\_\_\_\_ ft. Discharge \_\_\_\_\_ g.p.m. Date of test \_\_\_\_\_

12. Tunnel: Type of lining

Dimensions: \_\_\_\_\_  
(Length, course, and cross sectional size)  
Position of water bearing stratum with reference to portal of tunnel \_\_\_\_\_

Log of tunnel: (Preceding table for log of well may be used, if desired. Give footage from portal and character of materials, as pertinent.)

13. Pumping Equipment:


(a) Pump *Jacuzzi Turbine* Capacity *500* g.p.m.  
(Make, type and size)  
(b) Motor *20 HP electric*  
(Type and horsepower)

14. Location of area irrigated or to be irrigated, or place of use if for purposes other than irrigation.

Township North or South	Range E. or W. of Willamette Meridian	Section	Forty-acre Tract	Number Acres To Be Irrigated	Date of Reclamation
<i>T4S</i>	<i>2W</i>	<i>21</i>	<i>NE 1/4 of SE 1/4</i>	<i>15.0</i>	<i>1955</i>
<i>"</i>	<i>"</i>	<i>"</i>	<i>SE 1/4 of SE 1/4</i>	<i>4.0</i>	<i>"</i>
<i>"</i>	<i>"</i>	<i>22</i>	<i>SW 1/4 of SW 1/4</i>	<i>9.0</i>	<i>"</i>
<i>"</i>	<i>"</i>	<i>"</i>	<i>NW 1/4 of SW 1/4</i>	<i>38.0</i>	<i>"</i>
<i>"</i>	<i>"</i>	<i>"</i>	<i>NE 1/4 of SW 1/4</i>	<i>8.0</i>	<i>"</i>
<i>"</i>	<i>"</i>	<i>"</i>	<i>SW 1/4 of NW 1/4</i>	<i>0.5</i>	<i>"</i>
<i>"</i>	<i>"</i>	<i>"</i>	<i>SE 1/4 of NW 1/4</i>	<i>1.0</i>	<i>"</i>
				<i>75.5</i>	

15. If the ground water supply is supplemental to an existing water supply, identification of any application for a permit, permit, certificate or adjudicated right to appropriate water made or held by the registrant.

Township 4S Range 2W, W.M.  
North

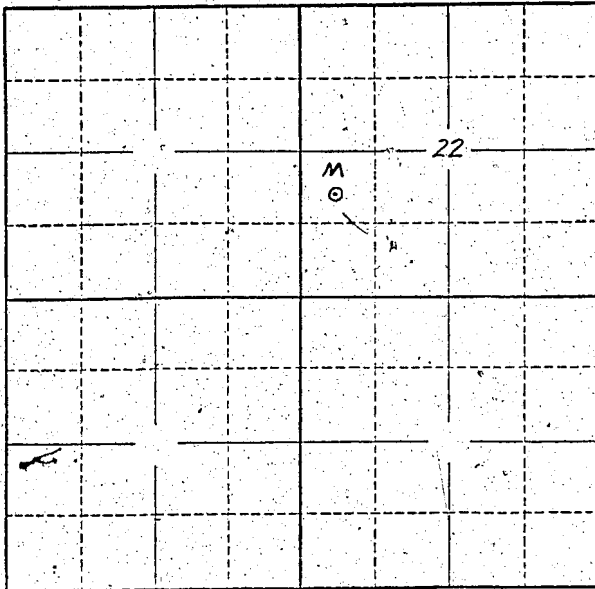

Locate well and acreage of irrigated land on plat.

Scale: 2" = 1 Mile

STATE OF OREGON

County of Marion

} ss.

I, Peter N. Kirk, being first duly sworn, do hereby certify that I have read the foregoing Registration Statement and that all of the items therein contained are true to the best of my knowledge and belief.

Peter N. Kirk  
(Signature of Registrant)

Subscribed and sworn to before me this 31st day of July, 1958.

My commission expires 12th June 1961

Wm. S. Bartholomew  
(Notary Public)

(SEAL)

**CERTIFICATE OF REGISTRATION**

STATE OF OREGON

County of Marion

} ss.

This is to certify that the foregoing Registration Statement was received in the office of the State Engineer on the 31st day of July, 1958, at 9:00 o'clock A. M. and has been duly recorded in said office in Book No. 13 of Registration Statements on page GR-3060

Witness my hand this 8th day of June, 1959

Stuart A. Stanley  
(State Engineer)

# 21.75

By \_\_\_\_\_ (Deputy)