

RECEIVED
MAY 19 1955
STATE ENGINEER
SALES OFFICE

REGISTRATION NO. GR-33
CERTIFICATE NO. GR-79

Registration Statement

OF CLAIMANT OF RIGHT TO APPROPRIATE GROUND WATER

(Under Chapter 708, Oregon Laws 1955.)

TO THE STATE ENGINEER OF OREGON:

I, William T. Ford
of Hubbard County of Marion

State of Oregon, do hereby make application for a certificate of registration as evidence of a right to appropriate ground water.

- 1. Source from which water is withdrawn is Hand pump well
(Flowing well, pump well, infiltration trench, or tunnel)
- 2. Location is: 3 miles south of Hubbard
(Approximate distance and direction from nearest city or town)

and is more particularly described as follows:

(a) 1700' N and 1700' W
1390' N and 1300' W from S.E. Corner Sec. 27
(Distance and bearing to corner of section or other legal subdivision)
being within John Corley NW 1/4 of SE 1/4 of Sec. 27
(Smallest legal subdivision) of Sec. 27, Twp. T4S, Rge. R4M
(N. or S.) (E. or W.)

or (b) within limits of recorded platted property, town or city:

in Lot _____, Block _____ of _____
(Name of plat or addition)
County of _____
(If within city or town, give name)

3. Construction Work was begun on March 12, 1953, was completed on March 23, 1953
(Date) (Date)

and the ground water claimed was first used for the purposes set out below on July 1953
(Date)

since which time the water has been used intermittently
(Continuously or Intermittently)

from 1953 to Sept. 1955
(Date) (Date)

4. Quantity of water claimed and used is 300 gallons per minute; _____ acre feet per year.

5. Purpose or Purposes for which water is used irrigation domestic
home in theater
(Domestic, irrigation, municipal, manufacturing, industrial, etc.)

6. Description of Well: Depth 98 feet. Type drilled
(Dug or drilled)
diameter 10 inches. Elevation of ground at well site 175' feet, mean sea level.
(As near as known)
Depth to water table 14' 6" feet.

7. Capacity of Well: 300 g.p.m. with 60 feet drawdown.
_____ g.p.m. with _____ feet drawdown.

Date of test March 23, 1953

If Flowing Well: Measured discharge _____ g.p.m. on _____
(Date)

Shut-in pressure at ground surface _____ lbs. per sq. in. on _____
(Date)

Water is controlled by _____
(Cap, valve, etc.)

8. Casing: (Give diameter, commercial specifications and depth below ground surface of each casing size.)

10 inch diameter from 0 to 93 feet
 inch diameter from to feet
 inch diameter from to feet
 inch diameter from to feet

Describe and show depth of shoe, plug, adapter, liner or other details:

9. Perforated Casings or Screens:

No. Perforations from to
 (Number per foot and size of perforations, or describe screen)
 from to
 from to
 from to

10. Log of Well: (Describe each stratum or formation clearly, indicate if water bearing, and give thickness and depth as indicated.)

MATERIAL	Thickness (Feet)	Depth to Bottom (Feet)
Surface	3	3
Clay	17	20
Sandy Clay	67	87
Blue Clay	7	94
Black Sand	4	98

If log of well is not available, give name and address of driller.

Richard Ore. R1

John T. Muller

11. Infiltration Trench: Covered or open

Dimensions: Length _____ ft. Minimum depth _____ ft. Maximum depth _____ ft.
 Bottom width _____ ft. Discharge _____ g.p.m. Date of test _____

12. Tunnel: Type of lining

Dimensions: _____
(Length, course, and cross sectional size)
 Position of water bearing stratum with reference to portal of tunnel _____

Log of tunnel: (Preceding table for log of well may be used, if desired. Give footage from portal and character of materials, as pertinent.)

13. Pumping Equipment:


(a) Pump Pacific Centrifugal Capacity 3.25 g.p.m.
(Make, type and size)
 (b) Motor G. E. 10 HP
(Type and horsepower)

14. Location of area irrigated or to be irrigated, or place of use if for purposes other than irrigation.

Township North or South	Range E. or W. of Willamette Meridian	Section	Forty-acre Tract	Number Acres To Be Irrigated	Date of Reclamation
4 S	R1W	27	NE 1/4 of SE 1/4 27	Total 26 acres	July 1953
4 S	R1W	27	NE 1/4 of SE 1/4	26	" "
"	"	"	NW 1/4 of SE 1/4	5	" "
"	"	"	SE 1/4 of NE 1/4	5	" "
			NW 1/4 of SE 1/4	13	
			SW 1/4 of SE 1/4	1	
			SE 1/4 of NE 1/4	1.5	
			NE 1/4 of SE 1/4	10	
			SW 1/4 of NE 1/4	.5	
				<u>26</u>	

15. If the ground water supply is supplemental to an existing water supply, identification of any application for a permit, permit, certificate or adjudicated right to appropriate water made or held by the registrant.

Township 45 Range 1W W.M. Sec. 27
North

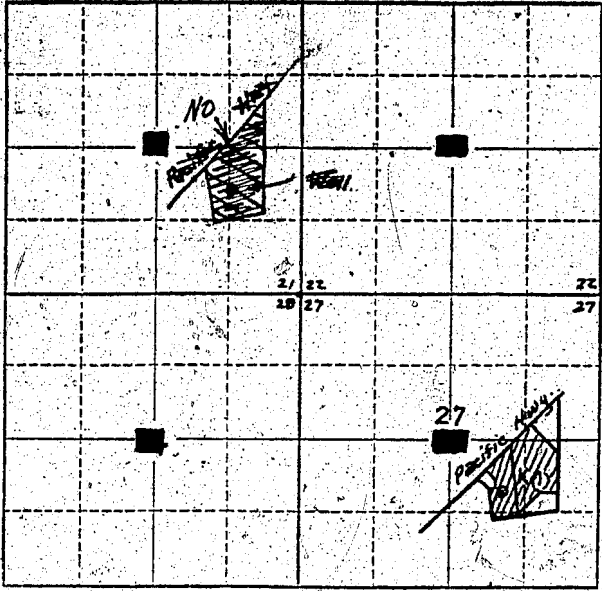

Locate well and acreage of irrigated land on plat.
Scale: 2" = 1 Mile

STATE OF OREGON
County of Marion } ss.

I, W. T. Lord, being first duly sworn, do hereby certify that I have read the foregoing Registration Statement and that all of the items therein contained are true to the best of my knowledge and belief.

William T. Lord
(Signature of Registrant)

Subscribed and sworn to before me this 3rd day of April, 1956

My commission expires Oct. 16, 1956
Glenn W. Wainwright
(Notary Public)

(SEAL)

CERTIFICATE OF REGISTRATION

STATE OF OREGON }
County of Marion } ss.

This is to certify that the foregoing Registration Statement was received in the office of the State Engineer on the 3rd day of November, 1955, at 8:00 o'clock A.M. and has been duly recorded in said office in Book No. 1 of Registration Statements on page GR-79-C.

Construction ^{is} ~~shall be~~ completed by _____, 19____, and the water ^{is} completely applied to beneficial use by _____, 19____.

Witness my hand this 12th day of April, 1956
Levin A. Stanley
(State Engineer)

By _____
(Deputy)