

Registration Statement

OF CLAIMANT OF RIGHT TO APPROPRIATE GROUND WATER

TO THE STATE ENGINEER OF OREGON:

I, Ernest R. Campbell and (Dorothy Campbell)

of Route 2, Box 455, Salem County of Washington

State of Oregon, do hereby make application for a certificate of registration as evidence of a right to appropriate ground water.

1. Source from which water is withdrawn is open well
(Flowing well, pump well, infiltration trench, or tunnel)

2. Location is: 1 1/2 miles east of downtown Salem
(Approximate distance and direction from nearest city or town)

* and is more particularly described as follows: 100 feet west & 750 feet north from SW corner of Section 21
Beginning S.W. corner lot 41, property situated 2150.0 feet north, from this point 277.12 east, thence south 1571.0 feet to center of

(a) Fruitland Rd. which is south line of lot 41 (1/2 mile west of Fruitland corner)
(Give distance and bearing to corner of section or other legal subdivision)

being within Capital City Fruit Farms of Sec. 21, Twp. 7 south, Rge. 2 west
(Smallest legal subdivision) (T. or S.) (R. or W.)

or (b) within limits of recorded platted property, town or city:

in Lot _____, Block _____ of _____
(Name of plat or addition)

County of _____
(If within city or town, give name)

3. Construction Work was begun on August 1951; was completed on Sept. 1951
(Date) (Date)

and the ground water claimed was first used for the purposes set out below on Sept. 1951
(Date)

since which time the water has been used continuously
(Continuously or intermittently)

from Sept. 1951 to present time (July 1956)
(Date) (Date)

4. Quantity of water claimed and used is 40 gallons per minute; _____ acre feet per year.

5. Purpose or Purposes for which water is used domestic, irrigation, stock, conference grounds and buildings associated with the same.
(Domestic, irrigation, municipal, manufacturing, industrial, etc.)

6. Description of Well: Depth 50 feet. Type drilled
(Dug or drilled)

diameter 6" inches. Elevation of ground at well site same as Salem feet, mean sea level.
(As near as known)

Depth to water table 13 feet.

7. Capacity of Well: 50 g.p.m. with 5 feet drawdown. This was only test made - potential capacity much more - need will require larger pump to utilize.
_____ g.p.m. with _____ feet drawdown.

Date of test August 1951


If Flowing Well: Measured discharge _____ g.p.m. on _____
(Date)

Shut-in pressure at ground surface _____ lbs. per sq. in. on _____
(Date)

Water is controlled by _____
(Cap, valve, etc.)

* The well itself is located approximately 200 feet north and 75 feet east of the southwest corner of lot 41, Capital City Fruit Farms.

Township 7 South Range 2 East, W.M.
North

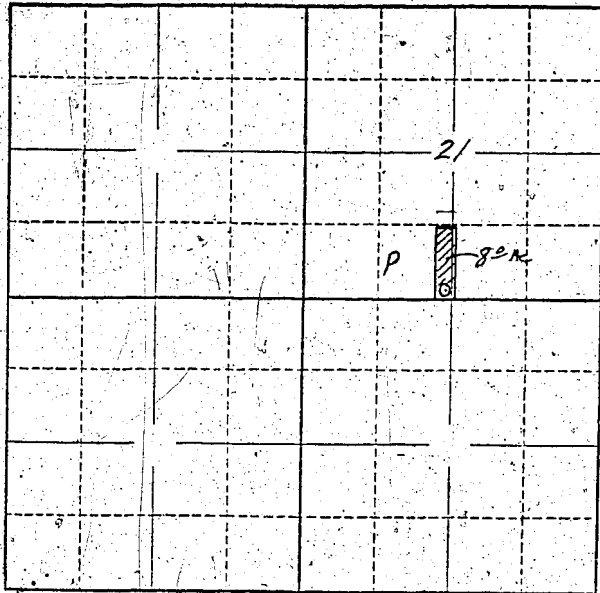

Locate well and acreage of irrigated land on plat.
Scale: 2" = 1 Mile

STATE OF OREGON

County of _____ } ss.

I, _____, being first duly sworn, do hereby certify that I have read the foregoing Registration Statement and that all of the items therein contained are true to the best of my knowledge and belief.

Ernest W. [Signature]
(Signature of Registrant)

Subscribed and sworn to before me this 31st day of July, 1958

My commission expires 12th June 1961 *Wm. S. Bartholomew*
(Notary Public)

(SEAL)

CERTIFICATE OF REGISTRATION

STATE OF OREGON

County of Marion } ss.

This is to certify that the foregoing Registration Statement was received in the office of the State Engineer on the 31st day of July, 1958, at 10:30 o'clock A. M. and has been duly recorded in said office in Book No. 13 of Registration Statements on page GR-3067

Witness my hand this 8th day of June, 1959

Lewis A. Stanley
(State Engineer)

By _____
(Deputy)

\$1500