

**RECEIVED**

JAN 3 1957

STATE ENGINEER  
SALEM, OREGON

**RECEIVED**

JAN 11 1957

STATE ENGINEER  
SALEM, OREGON

REGISTRATION NO. GR-331

CERTIFICATE NO. GR 2434

**Registration Statement**

**OF CLAIMANT OF RIGHT TO APPROPRIATE GROUND WATER**

(Under Chapter 708, Oregon Laws 1955.)

**TO THE STATE ENGINEER OF OREGON:**

I, DAN HEBELSEN

Route 1, Box 161-C

of HILLSBORO

County of WASHINGTON

State of OREGON, do hereby make application for a certificate of registration as evidence of a right to appropriate ground water.

1. Source from which water is withdrawn is Pump Well  
(Flowing well, pump well, infiltration trench, or tunnel)

2. Location is: 4 1/2 mi N.E. of Hillsboro  
(Approximate distance and direction from nearest city or town)

and is more particularly described as follows:

(a) 210 feet south and 66 feet west of 1/4 corner on east line of Sec. 3  
(Give distance and bearing to corner of section or other legal subdivision)

being within NE 1/4 of SE 1/4  
(Smallest legal subdivision) of Sec. 3, Twp. 1 N., Rge. 2 W.  
(N. or S.) (E. or W.)

or (b) within limits of recorded platted property, town or city:

in Lot \_\_\_\_\_, Block \_\_\_\_\_ of \_\_\_\_\_  
(Name of plat or addition)

County of \_\_\_\_\_  
(If within city or town, give name)

3. Construction Work was begun on Sept 11 1952; was completed on Sept 11 1952  
(Date) (Date)

and the ground water claimed was first used for the purposes set out below on June 1952  
(Date)

since which time the water has been used to maintain  
(Continuously or intermittently)

from April 30 to Oct 30  
(Date) (Date)

4. Quantity of water claimed and used is 80 gal per min. gallons per minute; \_\_\_\_\_ acre  
feet per year.

5. Purpose or Purposes for which water is used Irrigation of pasture  
and cultivated crops  
(Domestic, irrigation, municipal, manufacturing, industrial, etc.)

6. Description of Well: Depth 542 feet. Type Plugged  
(Dug or drilled)  
diameter 6" inches. Elevation of ground at well site 368'  
(As near as known) feet, mean sea level.

Depth to water table 110 feet.

7. Capacity of Well: 70 g.p.m. with 214 feet drawdown.

58 g.p.m. with 287 feet drawdown.

Date of test Sept 11 1952

If Flowing Well: Measured discharge \_\_\_\_\_ g.p.m. on \_\_\_\_\_

(Date)

Shut-in pressure at ground surface \_\_\_\_\_ lbs. per sq. in. on \_\_\_\_\_

(Date)

Water is controlled by \_\_\_\_\_ (Cap, valve, etc.)

8. Casing: (Give diameter, commercial specifications and depth below ground surface of each casing size.)

Describe and show depth of shoe, plug, adapter, liner or other details: .....

#### **9. Perforated Casings or Screens:**

*Unknown*  
(Number per foot and size of perforations, or describe screen) from to  
from to  
from to  
from to  
from to

10. Log of Well: (Describe each stratum or formation clearly, indicate if water bearing, and give thickness and depth as indicated.)

If log of well is not available, give name and address of driller.

~~BRT COUNT~~

No. 675

Aloha Oregon

11. Infiltration Trench: Covered or open .....

**Dimensions:** Length ..... ft. Minimum depth ..... ft. Maximum depth ..... ft.

**Bottom width** ..... ft. **Discharge** ..... g.p.m. **Date of test** .....

12. Tunnel: Type of lining

**Dimensions:** .....  
(Length, course, and cross sectional size)

**Position of water bearing stratum with reference to portal of tunnel**

**Log of tunnel:** (Preceding table for log of well may be used, if desired. Give footage from portal and character of materials, as pertinent.)


### 13. Pumping Equipment:

(a) Pump Byron Jackson Lubette Capacity 1 c.c. g.p.m.  
(Make, type and size)  
(b) Motor Slipmills 15 h.p.  
(Type and horsepower)

14. Location of area irrigated or to be irrigated, or place of use if for purposes other than irrigation.

15. If the ground water supply is supplemental to an existing water supply, identification of any application for a permit, permit, certificate or adjudicated right to appropriate water made or held by the registrant.

GR-2431

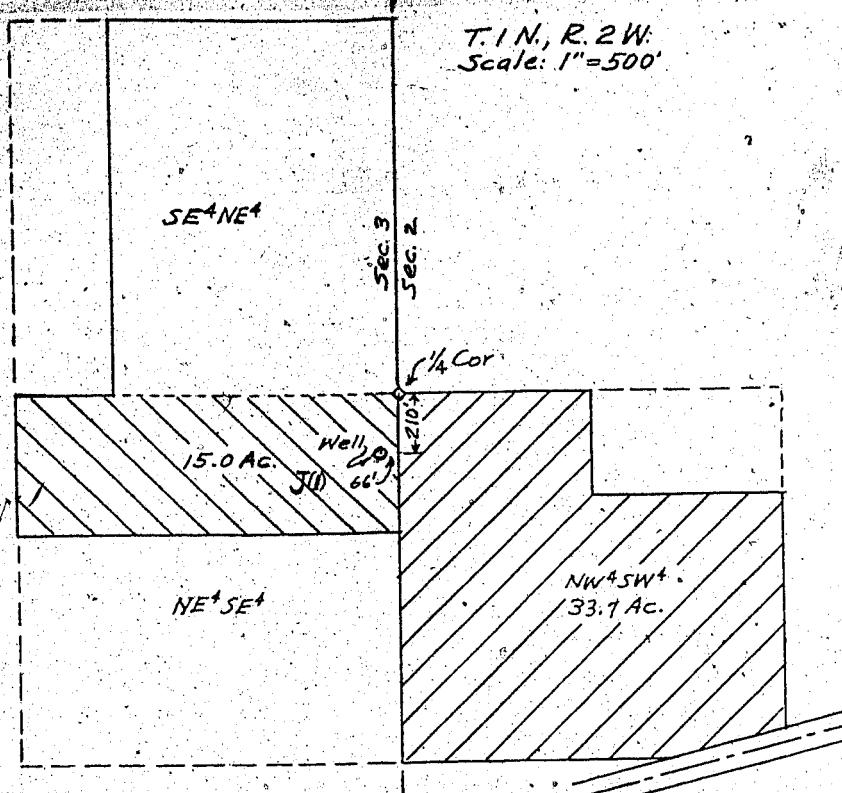

STATE OF OREGON

County of Marion

{ss.

I, ..... being first duly sworn, do hereby certify that I have read the foregoing Registration Statement and that all of the items therein contained are true to the best of my knowledge and belief.

*[Signature]*  
(Signature of Registrant)

Subscribed and sworn to before me this 29 day of June, 1956.

My commission expires 9-29-60

*[Signature]*  
(Notary Public)

(SEAL)

#### CERTIFICATE OF REGISTRATION

STATE OF OREGON

{ss.

County of Marion

This is to certify that the foregoing Registration Statement was received in the office of the State Engineer on the 4th day of January, 1957, at 8<sup>00</sup> o'clock A.M. and has been duly recorded in said office in Book No. 11 of Registration Statements on page GR-2431.

Witness my hand this 16<sup>th</sup> day of March, 1959.

*[Signature]*  
(State Engineer)

\$ 17.85

By

(Deputy)

GR-2431