

# Registration Statement

## OF CLAIMANT OF RIGHT TO APPROPRIATE GROUND WATER

TO THE STATE ENGINEER OF OREGON:

I, J. C. [unclear]  
of 123 [unclear] St. (Mailing address) Tillamook County of Oregon

State of Oregon, do hereby make application for a certificate of registration as evidence of a right to appropriate ground water.

1. Source from which water is withdrawn is Pump Well  
(Flowing well, pump well, infiltration trench, or tunnel)

2. Location is: 1 1/2 MILES WEST of TILLAMOOK  
(Approximate distance and direction from nearest city or town)

and is more particularly described as follows:

(a) 2 Ch. N. of 31 Ch W from the SE Cor. of the J. Pritchett D & C  
(Give distance and bearing to corner of section or other legal subdivision)  
being within NE 1/4 SW 1/4 of Sec. 30, Twp. 9 S., Rge. 3 W.  
(Smallest legal subdivision) (N. or S.) (E. or W.)

or (b) within limits of recorded platted property, town or city:

in Lot \_\_\_\_\_, Block \_\_\_\_\_ of \_\_\_\_\_  
(Name of plat or addition)  
\_\_\_\_\_ County of \_\_\_\_\_  
(If within city or town, give name)

3. Construction Work was begun on 1/1/38; was completed on 1/1/38  
(Date) (Date)

and the ground water claimed was first used for the purposes set out below on 1938  
(Date)

since which time the water has been used Continuously  
(Continuously or intermittently)

from MAY to SEPTEMBER  
(Date) (Date)

4. Quantity of water claimed and used is 5.00 gallons per minute; \_\_\_\_\_ acre feet per year.

5. Purpose or Purposes for which water is used Domestic  
(Domestic, irrigation, municipal, manufacturing, industrial, etc.)

6. Description of Well: Depth 16 feet. Type Drilled  
(Dug or drilled)  
diameter 4 1/2 inches. Elevation of ground at well site 175 feet, mean sea level.  
(As near as known)  
Depth to water table unk. feet.

7. Capacity of Well: \_\_\_\_\_ g.p.m. with \_\_\_\_\_ feet drawdown.  
\_\_\_\_\_ g.p.m. with \_\_\_\_\_ feet drawdown.

Date of test \_\_\_\_\_

If Flowing Well: Measured discharge \_\_\_\_\_ g.p.m. on \_\_\_\_\_  
(Date)


Shut-in pressure at ground surface \_\_\_\_\_ lbs. per sq. in. on \_\_\_\_\_  
(Date)

Water is controlled by \_\_\_\_\_  
(Cap, valve, etc.)





Township 9S Range 3W, W.M.  
North

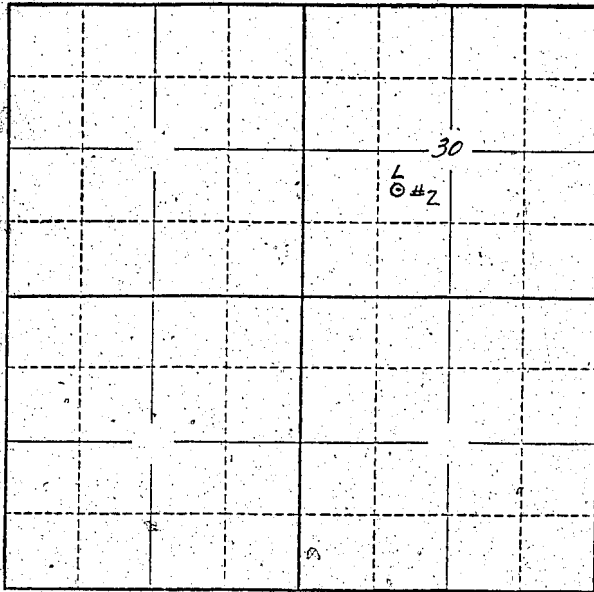

Locate well and acreage of irrigated land on plat.  
Scale: 2" = 1 Mile

STATE OF OREGON

County of \_\_\_\_\_ } ss.

I, \_\_\_\_\_, being first duly sworn, do hereby certify that I have read the foregoing Registration Statement and that all of the items therein contained are true to the best of my knowledge and belief.

(Signature of Registrant)

Subscribed and sworn to before me this 29 day of July, 1958

My commission expires July 19, 1959

*Robert A. Wright*  
(Notary Public)

(SEAL)

**CERTIFICATE OF REGISTRATION**

STATE OF OREGON

County of Marion } ss.

This is to certify that the foregoing Registration Statement was received in the office of the State Engineer on the 31st day of July, 1958, at 11:15 o'clock A. M. and has been duly recorded in said office in Book No. 13 of Registration Statements on page GR-3072

Witness my hand this 8th day of June, 1959

*Clara A. Stanley*  
(State Engineer)

By \_\_\_\_\_ (Deputy)

17/40