

Registration Statement

OF CLAIMANT OF RIGHT TO APPROPRIATE GROUND WATER

TO THE STATE ENGINEER OF OREGON:

I, E. J. McCloud

of 1985 Claxter Road, Salem, Oreg. County of Marion
(Mailing address)

State of Oregon, do hereby make application for a certificate of registration as evidence of a right to appropriate ground water.

1. Source from which water is withdrawn is pump well
(Flowing well, pump well, infiltration trench, or tunnel)

2. Location is: 7 miles north of Salem
(Approximate distance and direction from nearest city or town)

and is more particularly described as follows: 2240 feet west of 300 feet South from NE corner Section 24

(a) 300 ft. SW of Buena Crest school
(Give distance and bearing to corner of section or other legal subdivision)

being within NW 1/4 of NE 1/4 of Sec. 24, Twp. 6 S, Rge. 3 W
(Smallest legal subdivision) (N. or S.) (E. or W.)

or (b) within limits of recorded platted property, town or city:

in Lot _____ Block _____ of _____
(Name of plat or addition)

County of _____
(If within city or town, give name)

3. Construction Work was begun on Sept. 1949; was completed on Sept. 1949
(Date) (Date)

and the ground water claimed was first used for the purposes set out below on June 1950
(Date)

since which time the water has been used intermittently
(Continuously or intermittently)

from June 1949 to July 1958
(Date) (Date)

4. Quantity of water claimed and used is 120 gallons per minute; 10 acre feet per year.

5. Purpose or Purposes for which water is used irrigation
(Domestic, irrigation, municipal, manufacturing, industrial, etc.)

6. Description of Well: Depth 82 feet. Type drilled
(Dug or drilled)

diameter 8" inches. Elevation of ground at well site 200 feet, mean sea level.
(As near as known)

Depth to water table 30 feet.

7. Capacity of Well: .45 g.p.m. with no measurable feet drawdown.
not tested g.p.m. with _____ feet drawdown.

Date of test Sept. 1949 - by driller

If Flowing Well: Measured discharge _____ g.p.m. on _____
(Date)

Shut-in pressure at ground surface _____ lbs. per sq. in. on _____
(Date)

Water is controlled by _____
(Cap, valve, etc.)

8. Casing: (Give diameter, commercial specifications and depth below ground surface of each casing size.)

8 inch diameter from surface to 82 feet

..... inch diameter from to feet

..... inch diameter from to feet

..... inch diameter from to feet

Describe and show depth of shoe, plug, adapter, liner or other details: not available

9. Perforated Casings or Screens:

Last 12 feet of casing perforated from 35 to
(Give number per foot and size of perforations, or describe screen.)

..... from to

..... from to

..... from to

10. Log of Well: (Describe each stratum or formation clearly, indicate if water bearing, and give thickness and depth as indicated.)

MATERIAL	Thickness (Feet)	Depth to Bottom (Feet)
Not available		

If log of well is not available, give name and address of driller.

Fred Wymore, Route 2, Salem, Oreg.

11. Infiltration Trench: Covered or open
 Dimensions: Length ft. Minimum depth ft. Maximum depth ft.

Bottom width ft. Discharge g.p.m. Date of test

12. Tunnel: Type of lining

Dimensions:
(Length, course, and cross sectional size)

Position of water bearing stratum with reference to portal of tunnel

Log of tunnel: (Preceding table for log of well may be used, if desired. Give footage from portal and character of materials, as pertinent.)

13. Pumping Equipment:

(a) Pump deep-well jet Capacity 120 g.p.m.
(Make, type and size)


(b) Motor 15 H.P. gasoline engine
(Type and horsepower)

14. Location of area irrigated or to be irrigated, or place of use if for purposes other than irrigation.

Township North or South	Range E or W of Willamette Meridian	Section	Forty-acre Tract	Number Acres To Be Irrigated	Date of Reclamation
7 S.	3 W	24	NW $\frac{1}{4}$ of NE $\frac{1}{4}$	12	June 1950

15. If the ground water supply is supplemental to an existing water supply, identification of any application for a permit, permit, certificate or adjudicated right to appropriate water made or held by the registrant.

Township 6 S Range 3 W W.M.
North

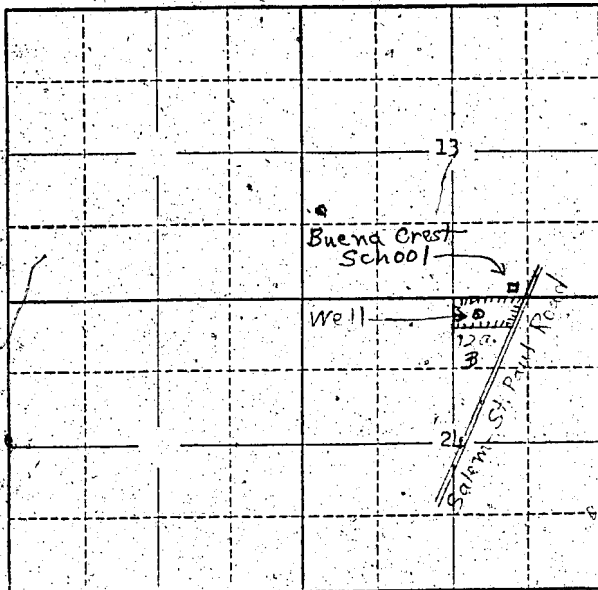

Locate well and acreage of irrigated land on plat.

Scale: 2" = 1 Mile

STATE OF OREGON

County of Marion } ss.

I, _____ being first duly sworn, do hereby certify that I have read the foregoing Registration Statement and that all of the items therein contained are true to the best of my knowledge and belief.

E. J. McCloud
(Signature of Registrant)

Subscribed and sworn to before me this 31 day of July, 1958.

My commission expires Nov 23, 1958. *Blanche Keckel*
(Notary Public)

(SEAL)

CERTIFICATE OF REGISTRATION

STATE OF OREGON

County of Marion } ss.

This is to certify that the foregoing Registration Statement was received in the office of the State Engineer on the 31st day of July, 1958, at 11:15 o'clock A.M. and has been duly recorded in said office in Book No. 13 of Registration Statements on page GR-3074

Witness my hand this 8th day of June, 1959

Lewis A. Stanley
(State Engineer)

By _____ (Deputy)

#1500

GR - 3074