

GR-3318
GR-3079

Registration Statement

OF CLAIMANT OF RIGHT TO APPROPRIATE GROUND WATER

(Under Chapter 708, Oregon Laws 1955.)

TO THE STATE ENGINEER OF OREGON:

I, BYRD E. HENDREN

of Stayton, Oregon County of Marion

State of Oregon, do hereby make application for a certificate of registration as evidence of a right to appropriate ground water.

1. Source from which water is withdrawn is pump well
(Flowing well, pump well, infiltration trench, or tunnel)

2. Location is: app. 5 miles from Stayton, Oregon.
(Approximate distance and direction from nearest city or town)

and is more particularly described as follows: 1640 feet North & 540 feet east from SW corner Section 24

(a) app. 80 feet from the Southwest corner of the Byrd E. Hendren farm in
(Give distance and bearing to corner of section or other legal subdivision)

being within North East corner of SE 1/4 of Sec. 24, Twp. 9 South, Rge. 2 West
(Smallest legal subdivision) (N. or S.) (E. or W.)

or (b) within limits of recorded platted property, town or city:

in Lot _____ Block _____ of _____
(Name of plat or addition)

County of _____
(If within city or town, give name)

3. Construction Work was begun on 1949; was completed on 1949
(Date) (Date)

and the ground water claimed was first used for the purposes set out below on 1949
(Date)

since which time the water has been used intermittently
(Continuously or intermittently)

from 1949 to 1958
(Date) (Date)

4. Quantity of water claimed and used is 216 gallons per minute; _____ acre feet per year.

5. Purpose or Purposes for which water is used irrigation

(Domestic, irrigation, municipal, manufacturing, industrial, etc.)

6. Description of Well: Depth 25 feet. Type drilled
(Dug or drilled)

diameter 8 inches. Elevation of ground at well site unknown feet, mean sea level.
(As near as known)

Depth to water table 11 feet.

7. Capacity of Well: 216 g.p.m. with 3 feet drawdown.

_____ g.p.m. with _____ feet drawdown.

Date of test during pumping

If Flowing Well: Measured discharge _____ g.p.m. on _____
(Date)

Shut-in pressure at ground surface _____ lbs. per sq. in. on _____
(Date)

Water is controlled by _____
(Cap, valve, etc.)

8. Casing: (Give diameter, commercial specifications and depth below ground surface of each casing size.)

8 inch diameter steel casing from top to 25 feet
 inch diameter from to feet
 inch diameter from to feet
 inch diameter from to feet

Describe and show depth of shoe, plug, adapter, liner or other details:

9. Perforated Casings or Screens:

Perforated casing from 15 ft to 25 ft. Level
 (Number per foot and size of perforations, or describe screen)
 from to
 from to
 from to

10. Log of Well: (Describe each stratum or formation clearly, indicate if water bearing, and give thickness and depth as indicated.) unknown; West Well Drilling, 4120 Market Street, Salem, Oregon did drilling.

MATERIAL	Thickness (Feet)	Depth to Bottom (Feet)
<u>unknown</u>		

If log of well is not available, give name and address of driller. West Well Drilling,
4120 Market Street, Salem, Oregon

11. Infiltration Trench: Covered or open

Dimensions: Length ft. Minimum depth ft. Maximum depth ft.

Bottom width ft. Discharge g.p.m. Date of test

12. Tunnel: Type of lining

Dimensions:
(Length, course, and cross sectional size)

Position of water bearing stratum with reference to portal of tunnel

Log of tunnel: (Preceding table for log of well may be used, if desired. Give footage from portal and character of materials, as pertinent.)

13. Pumping Equipment: Centrifugal

(a) Pump Pacific Fairbanks-Morris Jet Capacity 275 g.p.m.
(Make, type and size)


(b) Motor Tractor Motor electric House
(Type and horsepower)

14. Location of area irrigated or to be irrigated, or place of use if for purposes other than irrigation.

Township North or South	Range E. or W. of Willamette Meridian	Section	Forty-acre Tract	Number Acres To Be Irrigated	Date of Reclamation
T 9 South	R 2 West	24	40 acres NE 1/4 of SE 1/4	11.0	1941

15. If the ground water supply is supplemental to an existing water supply, identification of any application for a permit, permit, certificate or adjudicated right to appropriate water made or held by the registrant.

Township 9 South Range 2 West W.M.
North

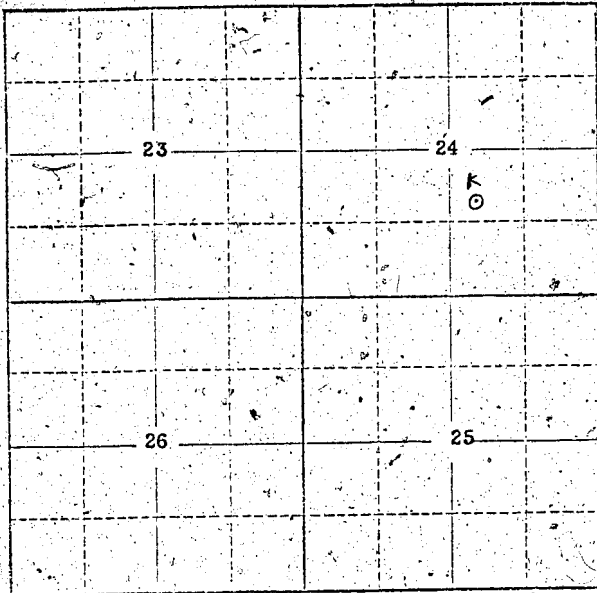

Locate well and acreage of irrigated land on plat.
Scale: 2" = 1 Mile

STATE OF OREGON

County of Marion

ss.

I, BYRD E. HENDREN, being first duly sworn, do hereby certify that I have read the foregoing Registration Statement and that all of the items therein contained are true to the best of my knowledge and belief.

Byrd E. Hendren
(Signature of Registrant)

Subscribed and sworn to before me this 31st day of July, 1958

My commission expires Sept. 20, 1959

George P. Duncan
(Notary Public for Oregon)

(SEAL)

CERTIFICATE OF REGISTRATION

STATE OF OREGON

County of Marion

ss.

This is to certify that the foregoing Registration Statement was received in the office of the State Engineer on the 31st day of July, 1958, at 11:30 o'clock A.M. and has been duly recorded in said office in Book No. 13 of Registration Statements on page GR-3079

Construction shall be completed by ~~XXXXXX~~ 1959 and the water completely applied to beneficial use by ~~XXXXXX~~ 1959

Witness my hand this 16th day of June, 1959

Leura A. Stanley
(State Engineer)

By

(Notary)

GR-3079

\$ 15.00