

Registration Statement

OF CLAIMANT OF RIGHT TO APPROPRIATE GROUND WATER

TO THE STATE ENGINEER OF OREGON:

I, Wilbur Chandler

of Route 1, Box 122, Dayton County of Yamhill
(Mailing address)

State of Oregon, do hereby make application for a certificate of registration as evidence of a right to appropriate ground water.

1. Source from which water is withdrawn is pump well
(Flowing well, pump well, infiltration trench, or tunnel)

2. Location is: seven miles south of Dayton (Grand Island)
(Approximate distance and direction from nearest city or town)

and is more particularly described as follows:

(a) S. 54° W. 1050' from 1/2 corner on North side - Sec. 22
(Give distance and bearing to corner of section or other legal subdivision)

being within NW 1/4 of NW 1/4 of Sec. 22, Twp. 5S, Rge. 3W
(Smallest legal subdivision) (N. or S.) (E. or W.)

or (b) within limits of recorded platted property, town or city:

in Lot _____, Block _____ of _____
(Name of plat or addition)

County of _____
(If within city or town, give name)

3. Construction Work was begun on May 1939; was completed on June 1939
(Date) (Date)

and the ground water claimed was first used for the purposes set out below on June 1939
(Date)

since which time the water has been used continuously
(Continuously or Intermittently)

from June 1939 to July 1958
(Date) (Date)

4. Quantity of water claimed and used is 240 gallons per minute; _____ acre feet per year.

5. Purpose or Purposes for which water is used irrigation

(Domestic, irrigation, municipal, manufacturing, industrial, etc.)

6. Description of Well: Depth 24 feet. Type drilled
(Dug or drilled)

diameter 8 inches. Elevation of ground at well site 100 feet, mean sea level.
(As near as known)

Depth to water table 10 feet.

7. Capacity of Well: 240 g.p.m. with 8 feet drawdown.

_____ g.p.m. with _____ feet drawdown.

Date of test not tested

If Flowing Well: Measured discharge _____ g.p.m. on _____
(Date)

Shut-in pressure at ground surface _____ lbs. per sq. in. on _____
(Date)

Water is controlled by _____
(Cap, valve, etc.)

8. Casing: (Give diameter, commercial specifications and depth below ground surface of each casing size.)

8 inch diameter from 0 to 24 feet
 inch diameter from to feet
 inch diameter from to feet
 inch diameter from to feet

Describe and show depth of shoe, plug, adapter, liner or other details:

9. Perforated Casings or Screens:

slots 1/2" x 5" from 18 to 23
(Number per foot and size of perforations, or describe screen)
 from to
 from to
 from to

10. Log of Well: (Describe each stratum or formation clearly, indicate if water bearing, and give thickness and depth as indicated.)

MATERIAL	Thickness (Feet)	Depth to Bottom (Feet)
topsoil	10	10
sand	8	18
gravel	6	24

If log of well is not available, give name and address of driller.driller unknown.....

11. Infiltration Trench: Covered or open

Dimensions: Length ft. Minimum depth ft. Maximum depth ft.

Bottom width ft. Discharge g.p.m. Date of test

12. Tunnel: Type of lining

Dimensions:
(Length, course, and cross sectional size)

Position of water bearing stratum with reference to portal of tunnel

Log of tunnel: (Preceding table for log of well may be used, if desired. Give footage from portal and character of materials, as pertinent.)

13. Pumping Equipment:

(a) Pump Fairbanks-Morse Centrifugal 1-2" Capacity 240 g.p.m.
(Make, type and size)

(b) Motor 10 HP 3Ø 240V
(Type and horsepower)


14. Location of area irrigated or to be irrigated, or place of use if for purposes other than irrigation.

Township North or South	Range E. or W. of Willamette Meridian	Section	Forty-acre Tract	Number Acres To Be Irrigated	Date of Reclamation
5S	3W	22	NE $\frac{1}{4}$ of NW $\frac{1}{4}$	31.0	June 1939

15. If the ground water supply is supplemental to an existing water supply, identification of any application for a permit, permit, certificate or adjudicated right to appropriate water made or held by the registrant.

N. S. N. E.

Township 55 Range 3W, W.M.
North

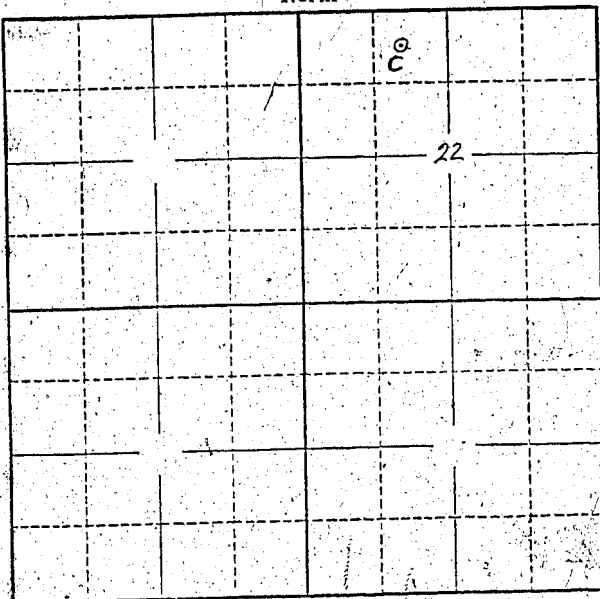

Locate well and acreage of irrigated land on plat.
Scale: 2" = 1 Mile

STATE OF OREGON

County of Umatilla } ss.

I, Willow Chandler, being first duly sworn, do hereby certify that I have read the foregoing Registration Statement and that all of the items therein contained are true to the best of my knowledge and belief.

Willow Chandler
(Signature of Registrant)

Subscribed and sworn to before me this 31st day of July, 1958

My commission expires Sept 29, 1961

Robert M. Cansler
(Notary Public)

(SEAL)

CERTIFICATE OF REGISTRATION

STATE OF OREGON

County of Marion } ss.

This is to certify that the foregoing Registration Statement was received in the office of the State Engineer on the 31st day of July, 1958, at 11:15 o'clock A.M. and has been duly recorded in said office in Book No. 13 of Registration Statements on page GR-3081

Witness my hand this 16th day of June, 1959

Leura G. Stanley
(State Engineer)

By _____ (Deputy)

\$15.15