

Registration Statement

OF CLAIMANT OF RIGHT TO APPROPRIATE GROUND WATER

TO THE STATE ENGINEER OF OREGON:

I, Arthur H. Van Loo
 of Rte 2 Box 384 County of Tillamook
(Mailing address)
 State of Oregon, do hereby make application for a certificate of registration as evidence of a right to appropriate ground water.

1. Source from which water is withdrawn is Pump
(Flowing well, pump well, infiltration trench, or tunnel)

2. Location is: 3 mi S.E. Tillamook
(Approximate distance and direction from nearest city or town)

and is more particularly described as follows: 1960 feet North & 320 feet east from SW Corner Section 33.

(a) 10 A off west side of SW 1/4 of Tract D L C 7 1/2
 being within 33 West NW 1/4 of Section 33 of Sec. 33, Twp. 1 South, Rge. 9 West
(Smallest legal subdivision) (Give distance and bearing to corner of section or other legal subdivision) (N. or S.) (E. or W.)

or (b) within limits of recorded-platted property, town or city:

in Lot _____, Block _____ of _____
(Name of plat or addition)

County of _____
(If within city or town, give name)

3. Construction Work was begun on 1945; was completed on 1945
(Date) (Date)

and the ground water claimed was first used for the purposes set out below on July 1945
(Date)

since which time the water has been used Continuously
(Continuously or intermittently)

from July 1945 to July 58
(Date) (Date)

4. Quantity of water claimed and used is 16.0 gallons per minute; _____ acre feet per year.

5. Purpose or Purposes for which water is used Irrigation

(Domestic, irrigation, municipal, manufacturing, industrial, etc.)

6. Description of Well: Depth 24 feet. Type Drilled
(Dug or drilled)

diameter 8 inches. Elevation of ground at well site _____ feet, mean sea level.
(As near as known)

Depth to water table 15 feet.

7. Capacity of Well: 20.0 g.p.m. with 4 feet drawdown.

_____ g.p.m. with _____ feet drawdown.

Date of test _____

If Flowing Well: Mean discharge _____ g.p.m. on _____
(Date)

Shut-in pressure at ground surface _____ lbs. per sq. in. on _____
(Date)

Water is controlled by _____
(Cap, valve, etc.)

If log of well is not available, give name and address of driller. Dont Know
well was drilled before I bought place

11. Infiltration Trench: Covered or open _____
 Dimensions: Length _____ ft. Minimum depth _____ ft. Maximum depth _____ ft.
 Bottom width _____ ft. Discharge _____ g.p.m. Date of test _____

12. Tunnel: Type of lining _____
 Dimensions: _____
(Length, course, and cross sectional size)
 Position of water bearing stratum with reference to portal of tunnel _____

Log of tunnel: (Preceding table for log of well may be used, if desired. Give footage from portal and character of materials, as pertinent.)

13. Pumping Equipment:
 (a) Pump Jacuzzi Capacity 200 g.p.m.
(Make, type and size)
 (b) Motor 7 1/2
(Type and horsepower)


14. Location of area irrigated or to be irrigated, or place of use if for purposes other than irrigation.

Township North or South	Range E. or W. of Willamette Meridian	Section	Forty-acre Tract	Number Acres To Be Irrigated	Date of Reclamation
15R9N	11W	32	SE 1/4 of SE 1/4	14.0	1945
15	9W	33	S. W. 1/4 of S. E. 1/4	11.0	"
15	9W	33	N. W. 1/4 of S. W. 1/4	19.0	"
15	11W	33	SW 1/4 NW 1/4	18.0	"
T15	R9E	33	NW 1/4 of NW 1/4	6.0 68.0	"

I have irrigated all but 6 to 8 acres of the 72 acres and that is Hill land that is too hard to get at.

15. If the ground water supply is supplemental to an existing water supply, identification of any application for a permit, permit, certificate or adjudicated right to appropriate water made or held by the registrant.

Township 15 Range 9 N, W.M.
North

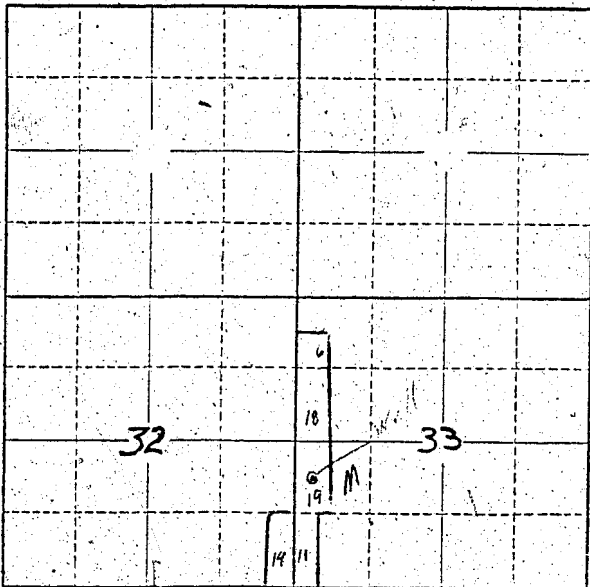

Locate well and acreage of irrigated land on plat.
Scale: 2" = 1 Mile

STATE OF OREGON

County of TILLAMOOK } ss.

I, Arthur W. VanLoo, being first duly sworn, do hereby certify that I have read the foregoing Registration Statement and that all of the items therein contained are true to the best of my knowledge and belief.

Arthur W. VanLoo
(Signature of Registrant)

Subscribed and sworn to before me this 28th day of July, 1958

My commission expires 8-3-61

Elyahuk Dayley
(Notary Public)

(SEAL)

CERTIFICATE OF REGISTRATION

STATE OF OREGON

County of Marion } ss.

This is to certify that the foregoing Registration Statement was received in the office of the State Engineer on the 31 day of July, 1958, at 8:00 o'clock A.M. and has been duly recorded in said office in Book No. 14 of Registration Statements on page GR-3251

Witness my hand this 20th day of July, 1959

Lewis A. Estabrook
(State Engineer)

By _____
(Deputy)

GR - 3251

7 20.50