REGISTRATION NO. [illegible]

CERTIFICATE NO. [illegible]

Registration Statement

OF CLAIMANT OF RIGHT TO APPROPRIATE GROUND WATER

(Under Chapter 743, Oregon Laws 1955)

TO THE STATE ENGINEER OF OREGON:


of Route 2, Box 752, Homestead County of Washington

State of Oregon do hereby make application for a certificate of registration as evidence of a right to appropriate ground water.

1. Source from which water is withdrawn is Deep well

(Driven well, jetted well, bored well, dug well, spring, or name)

2. Location is: one half mile west of Hopkins

(Reasonably definite description of location from nearest city or town)

and is more particularly described as follows:




(Smallest legal subdivision) (N. or S.) (E. or W.)

or (b) within limits of recorded platted property, town or city

if Lot Block of

(Name of plat or addition)

County of Washington

(If within city or town, give name)

3. Construction Work was begun on [illegible] 19[illegible], was completed on [illegible] 19[illegible]

(Date) (Date)

and the ground water claimed was first used for the purposes set out below on [illegible] 19[illegible]

(Date)

since which time the water has been used [illegible]

(Continuously or intermittently)

from [illegible] to Present time.

(Date) (Date)

4. Quantity of water claimed and used is [illegible] gallons per minute [illegible] acre feet per year.

5. Purpose or Purposes for which water is used [illegible]

(Domestic, irrigation, municipal, power, mining, etc.)

6. Description of Well: Depth [illegible] feet, Type [illegible]

(Dug or drilled)

diameter [illegible] inches. Elevation of ground at well site [illegible] feet, mean sea level.

(If map is known)

Depth to water table [illegible] feet.

7. Capacity of Well [illegible] gpm. with [illegible] feet drawdown

[illegible] gpm. with [illegible] feet drawdown

Date of test [illegible]

If Flowing Well: Measured discharge [illegible] gpm. on [illegible] 19[illegible]

(Date)

Source of water in ground water [illegible] Bed of Well [illegible]

Water is encountered by [illegible]

(Drilling, boring, etc.)

8. **Casing:** (Give diameter, commercial specifications and depth below ground surface of each casing size.)

12 inch diameter steel from 0 to 32 feet

____ inch diameter ____ from ____ to ____ feet

____ inch diameter ____ from ____ to ____ feet

____ inch diameter ____ from ____ to ____ feet

Describe and show depth of shoe, plug, adapter, liner or other details: ____

9. **Perforated Casings or Screens:**

None from ____ to ____
(Number per foot and size of perforations, or describe screen)

____ from ____ to ____

____ from ____ to ____

____ from ____ to ____

10. **Log of Well:** (Describe each stratum or formation clearly, indicate if water bearing, and give thickness and depth as indicated.)

MATERIAL	Thickness (Feet)	Depth to Bottom (Feet)
Sand and clay	29	29
Grey rock	19	48
Soft red rock	4	52
Hard and soft grey rock	41	93
Soft rock, water bearing	20	113
Hard rock	11	124
Broken rock	2	126
Hard gray rock	1	127

GR-318 A

If log of well is not available, give name and address of driller. A. M. Johnson Drilling Co.

21075 S. W. Tualatin Valley Highway, Aloha, Oregon

11. **Infiltration Trench:** Covered or open .....

Dimensions: Length ..... ft. Minimum depth ..... ft. Maximum depth ..... ft.

Bottom width ..... ft. Discharge ..... g.p.m. Date of test .....

12. **Tunnel:** Type of lining .....

Dimensions: ..... (Length, course, and cross sectional size)

Position of water bearing stratum with reference to portal of tunnel .....

.....

Log of tunnel: (Preceding table for log of well may be used, if desired. Give footage from portal and character of materials, as pertinent.)

13. **Pumping Equipment:**

(a) Pump Byron Jackson Turbine, 8" bowl (Make, type and size) Capacity 220 g.p.m.

(b) Motor G. E. vertical hollow shaft, 20 H. P. electric (Type and horsepower)

14. Location of area irrigated or to be irrigated, or place of use if for purposes other than irrigation.

Township North or South	Range E. or W. of Willamette Meridian	Section	Forty-acre Tract	Number Acres To Be Irrigated	Date of Reclamation
1 S.	2 W.	23	NE¼ of SW¼	30.8	7-6-53
"	"	"	SE¼ of SW¼	34.6	" "
"	"	"	SW¼ of SW¼	8.0	" "
"	"	"	NW¼ of SE¼	17.6	" "
"	"	"	SW¼ of SE¼	12.0	" "
				103.0	

15. If the ground water supply is supplemental to an existing water supply, identification of any application for a permit, permit, certificate or adjudicated right to appropriate water made or held by the registrant.

.....

.....

GR-318B

Township 1S Range 24 W.M.

North

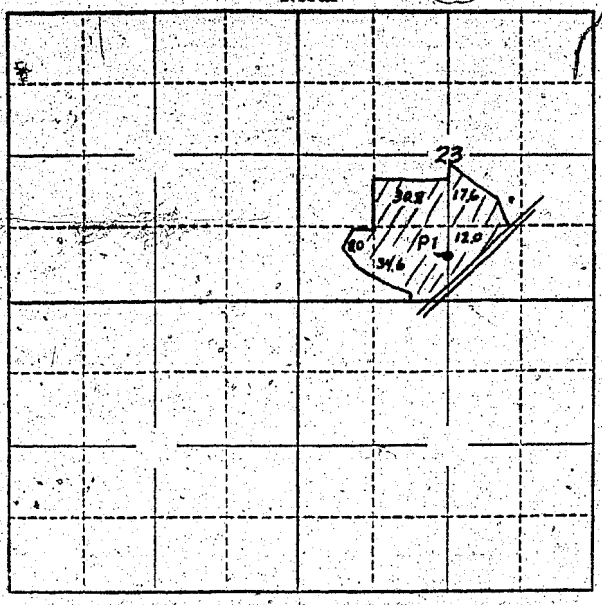

Locate well and acreage of irrigated land on plat. See attached map

Scale: 2" = 1 Mile

STATE OF OREGON }
County of ..... } ss.

I/We, John SANTORO & JOE SANTORO, being first duly sworn, do hereby certify that I have read the foregoing Registration Statement and that all of the items therein contained are true to the best of my knowledge and belief.

John Santoro Joe Santoro
(Signature of Registrant)

Subscribed and sworn to before me this 4th day of January, 19 57

My commission expires 4-3-59 Stanley Stuffman
(Notary Public)

(SEAL)

CERTIFICATE OF REGISTRATION

STATE OF OREGON }
County of Marion } ss.

This is to certify that the foregoing Registration Statement was received in the office of the State Engineer on the 11th day of January, 19 57, at 8:00 o'clock A.M. and has been duly recorded in said office in Book No. 2 of Registration Statements on page GR-318 C

~~Construction shall be completed by X-X-X-X-X-X-X-X-X, 19XX, and the water completely applied to beneficial use by X-X-X-X-X-X-X-X-X 19-X-X-~~

Witness my hand this 1st day of April, 19 57

Lewis A. Stanley
(State Engineer)

By .....
(Deputy)

#2565

GR-318C