

# Registration Statement

## OF CLAIMANT OF RIGHT TO APPROPRIATE GROUND WATER

TO THE STATE ENGINEER OF OREGON:

I, A. H. OWENS  
of Dillard County of Douglas  
(Mailing address)

State of Oregon, do hereby make application for a certificate of registration as evidence of a right to appropriate ground water.

1. Source from which water is withdrawn is PUMP-Well  
(Flowing well, pump well, infiltration trench, or tunnel)

2. Location is: Highway 99 - 1 1/2 mi. N. of Dillard  
(Approximate distance and direction from nearest city or town)

and is more particularly described as follows: 650 feet east & 215 feet north from W/4 corner Section 28

(a) LOT 1 OF MILLERS SUB-DIVISION  
(Give distance and bearing to corner of section or other legal subdivision)

being within MILLERS of Sec. 28, Twp. 28-S, Rge. 6-W  
(Smallest legal subdivision) (N. or S.) (E. or W.)

or (b) within limits of recorded platted property, town or city:

in Lot 1, Block \_\_\_\_\_ of PLAT - MILLERS - SUB-DIVISION  
(Name of plat or addition)

County of DOUGLAS

(If within city or town, give name)

3. Construction Work was begun on JULY-1945; was completed on JULY-1945  
(Date) (Date)

and the ground water claimed was first used for the purposes set out below on JULY-1945,  
(Date)

since which time the water has been used CONTINUOUSLY  
(Continuously or intermittently)

from MAY-1 to NOV-15  
(Date) (Date)

4. Quantity of water claimed and used is 50 gallons per minute; \_\_\_\_\_ acre feet per year.

5. Purpose or Purposes for which water is used FARM-

FARM-  
(Domestic, irrigation, municipal, manufacturing, industrial, etc.)

6. Description of Well: Depth 18 feet. Type DUG  
(Dug or drilled)

diameter 33 inches. Elevation of ground at well site 500 feet, mean sea level.  
(As near as known)

Depth to water table 5 feet.

7. Capacity of Well: 75 g.p.m. with 4 feet drawdown.

50 g.p.m. with 4 feet drawdown.

Date of test 1945 and 1953

If Flowing Well: Measured discharge \_\_\_\_\_ g.p.m. on \_\_\_\_\_  
(Date)

Shut-in pressure at ground surface \_\_\_\_\_ lbs. per sq. in. on \_\_\_\_\_  
(Date)

Water is controlled by \_\_\_\_\_  
(Cap, valve, etc.)

8. Casing: (Give diameter, commercial specifications and depth below ground surface of each casing size.)

33 inch diameter ..... from 30 1/4 - 30 1/4 + 5 to ..... feet  
inch diameter ..... from ..... to ..... feet  
inch diameter ..... from ..... to ..... feet  
inch diameter ..... from ..... to ..... feet

Describe and show depth of shoe, plug, adapter, liner or other details: .....

9. Perforated Casings or Screens:


(Number per foot and size of perforations, or describe screen) ..... from ..... to .....  
..... from ..... to .....  
..... from ..... to .....  
..... from ..... to .....

10. Log of Well: (Describe each stratum or formation clearly, indicate if water bearing, and give thickness and depth as indicated.)

MATERIAL	Thickness (Feet)	Depth to Bottom (Feet)
SANDY-Loam- 8 feet	8	
Gravel- 10 feet	10	18-
Bed Rock- at 18 feet		



Township 28S Range 6W W.M.  
North

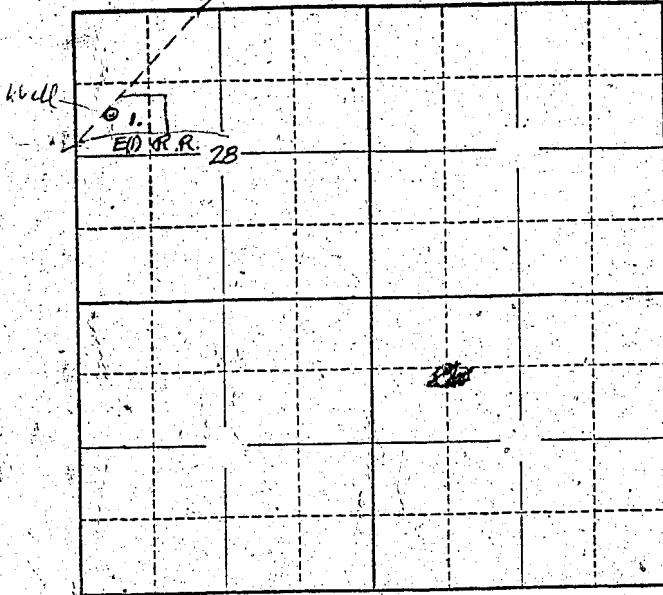

Locate well and acreage of irrigated land on plat.  
Scale: 2" = 1 Mile

STATE OF OREGON

County of Lincoln

} ss.

I, A. G. [Signature], being first duly sworn, do hereby certify that I have read the foregoing Registration Statement and that all of the items therein contained are true to the best of my knowledge and belief.

[Signature]  
(Signature of Registrant)

Subscribed and sworn to before me this 30th day of July, 1958

My commission expires Aug 21 1960

[Signature]  
(Notary Public)

(SEAL)

**CERTIFICATE OF REGISTRATION**

STATE OF OREGON

County of Marion

} ss.

This is to certify that the foregoing Registration Statement was received in the office of the State Engineer on the 31st day of July, 1958, at 8:00 o'clock A. M. and has been duly recorded in said office in Book No. 13 of Registration Statements on page GR-3090

Witness my hand this 16th day of June, 1959

[Signature]  
(State Engineer)

\$15.00

By \_\_\_\_\_ (Deputy)