

# Registration Statement

## RECEIVED OF CLAIMANT OF RIGHT TO APPROPRIATE GROUND WATER

MAR 1950  
STATE ENGINEER

TO THE STATE ENGINEER OF OREGON:

I, Hern Roy Murphy  
of P.O. Box 28, ALVADORE County of LANE  
State of Oregon, do hereby make application for a certificate of registration as evidence of a right to appropriate ground water.

- 1. Source from which water is withdrawn is pump well  
(Flowing well, pump well, infiltration trench, or tunnel)
- 2. Location is: 1/2 mile west of ALVADORE  
(Approximate distance and direction from nearest city or town)

and is more particularly described as follows:  
3/4 Sec. CORNER 35 3400' west then south 800' to well

being within Block 26 NE 1/4 NE 1/4 of Sec. 30, Twp. 7 N 13 E, Rge. B 5 W  
(Smallest legal subdivision) (S. of S.) (E. or W.)

or (b) within limits of recorded platted property, town or city: ALVADORE

in Lot 19, Block 26 of Second Addition west of Alvadore  
(Name of plat or addition)  
ALVADORE County of LANE  
(If within city or town, give name)

- 3. Construction Work was begun on AUG 5 1950; was completed on AUG 12 1950  
(Date) (Date)

and the ground water claimed was first used for the purposes set out below on AUG 20 1950  
(Date)

since which time the water has been used Continuously  
(Continuously or intermittently)

from AUG 20 1950 to JULY 25 1955  
(Date) (Date)

- 4. Quantity of water claimed and used is FOUR gallons per minute; net four acre feet per year.

- 5. Purpose or Purposes for which water is used IRRIGATION  
(Domestic, irrigation, municipal, manufacturing, industrial, etc.)

- 6. Description of Well: Depth 132 feet. Type DRILLED  
(Dug or drilled)

diameter 5 inches. Elevation of ground at well site 200.00 feet, mean sea level.  
(As far as known)

Depth to water table 8 feet.

- 7. Capacity of Well: 11 g.p.m. with 60 feet drawdown.  
..... g.p.m. with ..... feet drawdown.

Date of test .....

If Flowing Well: Measured discharge ..... g.p.m. on .....  
(Date)

Shut-in pressure at ground surface ..... lbs. per sq. in. on .....  
(Date)

Water is controlled by .....  
(Cap, valve, etc.)

8. Casing: (Give diameter, commercial specifications and depth below ground surface of each casing size.)

5 inch diameter from 0 to 126 feet  
inch diameter from to feet  
inch diameter from to feet  
inch diameter from to 7 feet

Describe and show depth of shoe, plug, adapter, liner or other details:

9. Perforated Casings or Screens:

(Number per foot and size of perforations, or describe screen)

from to  
from to  
from to  
from to

10. Log of Well: (Describe each stratum or formation clearly, indicate if water bearing, and give thickness and depth as indicated.)

| MATERIAL | Thickness (Feet) | Depth to Bottom (Feet) |
|----------|------------------|------------------------|
|          |                  |                        |
|          |                  |                        |
If log of well is not available, give name and address of driller. *ED - O'DNeal*

*Spring Field Oregon*

11. Infiltration Trench:  Covered or open  .....  
 Dimensions: Length ..... ft. Minimum depth ..... ft. Maximum depth ..... ft.  
 Bottom width ..... ft. Discharge ..... g.p.m. Date of test .....

12. Tunnel: Type of lining .....  
 Dimensions: .....  
(Length, course, and cross sectional size)  
 Position of water bearing stratum with reference to portal of tunnel .....

Log of tunnel: (Preceding table for log of well may be used, if desired. Give footage from portal and character of materials, as pertinent.)


13. Pumping Equipment:  
 (a) Pump ~~Electric~~ *DORWARD DEEP WELL JET* Capacity *30* g.p.m.  
(Make, type and size)  
 (b) Motor *ELECTRIC* *1 HORSE*  
(Type and horsepower)

14. Location of area irrigated or to be irrigated, or place of use if for purposes other than irrigation.

| Township North or South | Range E. or W. of Willamette Meridian | Section      | Forty-acre Tract  | Number Acres To Be Irrigated | Date of Reclamation |
|-------------------------|---------------------------------------|--------------|---|------------------------------|---------------------|
| <del>717S</del>         | <del>5W</del>                         | <del>3</del> | <del>Block 20</del>   | <del>2.9 Total</del>         | 1950                |
| 717S                    | 5W                                    | 3            | NE <sup>1</sup> / <sub>4</sub> + NE <sup>1</sup> / <sub>4</sub> | 2.9 Total                    | "                   |
|                         |                                       |              |   |                              |                     |
|                         |                                       |              |   |                              |                     |
15. If the ground water supply is supplemental to an existing water supply, identification of any application for a permit, permit, certificate or adjudicated right to appropriate water made or held by the registrant.

175 5W  
 Township 16S Range 5W, W.M.  
 North

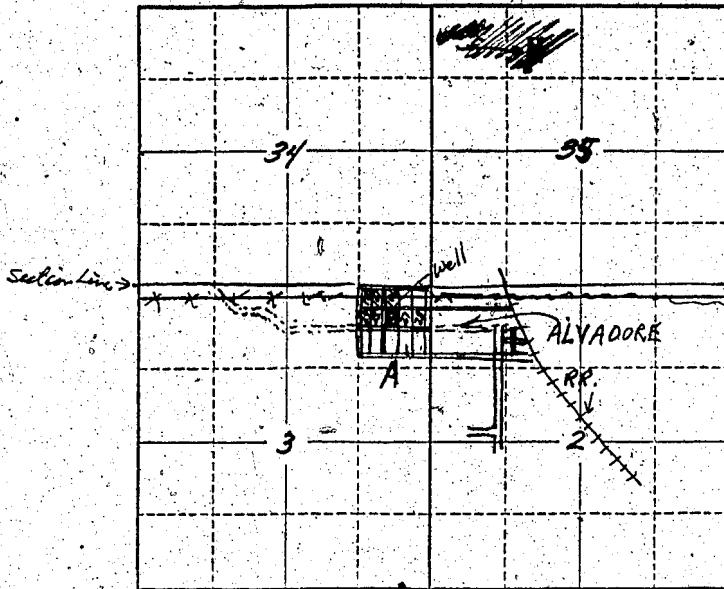

Locate well and acreage of irrigated land on plat.  
 Scale: 2" = 1 Mile

STATE OF OREGON

County of LANE } ss.

I, Veron L. Murphy, being first duly sworn, do hereby certify that I have read the foregoing Registration Statement and that all of the items therein contained are true to the best of my knowledge and belief.

Veron L. Murphy  
 (Signature of Registrant)

Subscribed and sworn to before me this 30th day of July, 1958.

My commission expires March 13, 1961

James A. [unclear]  
 (Notary Public)

(SEAL)

**CERTIFICATE OF REGISTRATION**

STATE OF OREGON

County of Marion } ss.

This is to certify that the foregoing Registration Statement was received in the office of the State Engineer on the 31st day of July, 1958, at 8:00 o'clock A. M. and has been duly recorded in said office in Book No. 16 of Registration Statements on page GR 4016

Witness my hand this 15th day of March, 1960.

[Signature]  
 (State Engineer)

By \_\_\_\_\_  
 (Deputy)

GR 4016

7/15/58