

JUL 31 1958
STATE ENGINEER
SALEM, ORE.

Registration No. GR - 3346
Certificate No. GR 3098

Registration Statement

OF CLAIMANT OF RIGHT TO APPROPRIATE GROUND WATER

TO THE STATE ENGINEER OF OREGON:

I, KARL W. EISENHARDT
of 3235 JAMES LANE County of LANE
(Mailing address)

State of Ore., do hereby make application for a certificate of registration as evidence of a right to appropriate ground water.

1. Source from which water is withdrawn is Pump Well
(Flowing well, pump well, infiltration trench, or tunnel)

2. Location is: 5 miles North Eugene
(Approximate distance and direction from nearest city or town)

and is more particularly described as follows: 160 feet west & 1321 feet South from NE Corner Section 12

(a) 7 E 1/4 Sec 12 T17S, R1W, W.M.
(Give distance and bearing to corner of section or other legal subdivision)

being within SW 1/4 of NE 1/4 of Sec. 12, Twp. 17S, Rge. 4W
(Smallest legal subdivision) (or S.) (or W.)

or (b) within limits of recorded platted property, town or city: Santa Clara

in Lot _____, Block _____ of _____
(Name of plat or addition)
County of _____
(If within city or town, give name)

3. Construction Work was begun on unknown; was completed on unknown
(Date) (Date)

and the ground water claimed was first used for the purposes set out below on 1946
(Date)

since which time the water has been used _____
(Continuously or intermittently)

from 1946 to 1957
(Date) (Date)

4. Quantity of water claimed and used is 100 gallons per minute; 8 acre feet per year.

5. Purpose or Purposes for which water is used Irrigation
(Domestic, irrigation, municipal, manufacturing, industrial, etc.)

6. Description of Well: Depth 21 feet. Type Driven well
(Dug or drilled)

diameter 2 1/2 inches. Elevation of ground at well site _____ feet, mean sea level.
(As near as known)

Depth to water table 8 feet.

7. Capacity of Well: 200 g.p.m. with static feet drawdown.

_____ g.p.m. with _____ feet drawdown.


Date of test 1949

If Flowing Well: Measured discharge _____ g.p.m. on _____
(Date)

Shut-in pressure at ground surface _____ lbs. per sq. in. on _____
(Date)

Water is controlled by _____
(Cap, valve, etc.)

Township 17^S Range 4^W W.M.
North

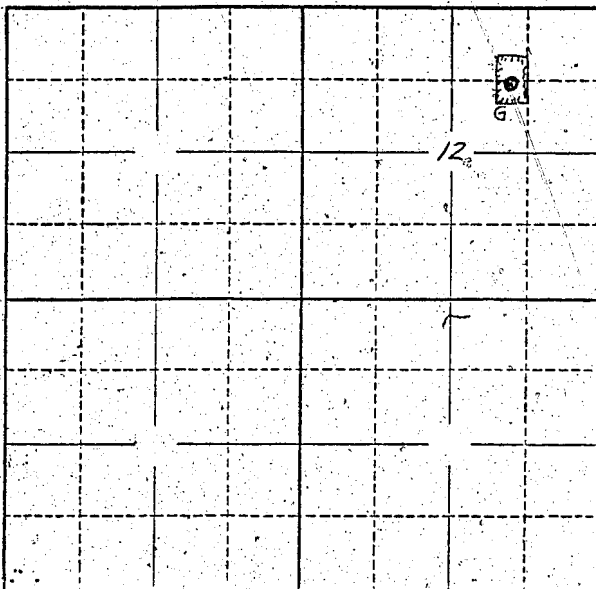

Locate well and acreage of irrigated land on plat.
Scale: 2" = 1 Mile

STATE OF OREGON

County of Wash } ss.

I, Karl W. Eisenhardt, being first duly sworn, do hereby certify that I have read the foregoing Registration Statement and that all of the items therein contained are true to the best of my knowledge and belief.

Subscribed and sworn to before me this 31st day of July, 1958

My commission expires June 23 1961

Karl W. Eisenhardt
(Signature of Registrant)
Karl W. Eisenhardt
(Notary Public)

(SEAL)

CERTIFICATE OF REGISTRATION

STATE OF OREGON

County of Marion } ss.

This is to certify that the foregoing Registration Statement was received in the office of the State Engineer on the 31st day of July, 1958, at 9:00 o'clock A. M. and has been duly recorded in said office in Book No. 13 of Registration Statements on page GR-3098

Witness my hand this 16th day of June, 1959

\$15.00

Lewis A. Stanley
(State Engineer)
By _____
(Deputy)