

Registration Statement

JUL 31 1950

STATE ENGINEER OF CLAIMANT OF RIGHT TO APPROPRIATE GROUND WATER

TO THE STATE ENGINEER OF OREGON:

I, ARNOLD WALKER

of P.O. BOX 12, TILLAMOOK County of TILLAMOOK

State of OREGON, do hereby make application for a certificate of registration as evidence of a right to appropriate ground water.

1. Source from which water is withdrawn is Pump Well
(Flowing well, pump well, infiltration trench, or tunnel)

2. Location is: 2 1/2 Miles SW Tillamook
(Approximate distance and direction from nearest city or town)

and is more particularly described as follows:

(a) 1613.30 South and 3035.39 East of 1/4 cor between Sec 26-27
(Give distance and bearing to corner of section or other legal subdivision)

being within part Lot 5 of Sec. 26, Twp. 1.25, Rge. 10.W.
(Smallest legal subdivision) (N. or S.) (E. or W.)

or (b) within limits of recorded platted property, town or city:

in Lot _____, Block _____ of _____
(Name of plat or addition)

County of Tillamook
(If within city or town, give name)

3. Construction Work was begun on Sept. 1952; was completed on Sept. 1952
(Date) (Date)

and the ground water claimed was first used for the purposes set out below on July 1953
(Date)

since which time the water has been used Continuously
(Continuously or intermittently)

from July 1953 to July 1958
(Date) (Date)

4. Quantity of water claimed and used is 275 gallons per minute; _____ acre feet per year.

5. Purpose or Purposes for which water is used Irrigation, ~~domestic~~ use

(Domestic, irrigation, municipal, manufacturing, industrial, etc.)

6. Description of Well: Depth 120 feet. Type Drilled
(Dug or drilled)

diameter 8 inches. Elevation of ground at well site 1.5 feet, mean sea level.
(As near as known)

Depth to water table 7 feet.

7. Capacity of Well: 275 g.p.m. with 5 feet drawdown.

_____ g.p.m. with _____ feet drawdown.

Date of test _____

If Flowing Well: Measured discharge _____ g.p.m. on _____
(Date)

Shut-in pressure at ground surface _____ lbs. per sq. in. on _____
(Date)

Water is controlled by _____
(Cap, valve, etc.)

8. Casing: (Give diameter, commercial specifications and depth below ground surface of each casing size.)

8 inch diameter from 0 to 120 feet
inch diameter from to feet
inch diameter from to feet
inch diameter from to feet

Describe and show depth of shoe, plug, adapter, liner or other details:
.....
.....

9. Perforated Casings or Screens:

Standard - punched $\frac{3}{8}$ " in. from 10 to 20
(Number per foot and size of perforations, or describe screen)
from to
from to
from to

10. Log of Well: (Describe each stratum or formation clearly, indicate if water bearing, and give thickness and depth as indicated.)

MATERIAL	Thickness (Feet)	Depth to Bottom (Feet)



If log of well is not available, give name and address of driller. Ross - Alohee

11. Infiltration Trench: Covered or open

Dimensions: Length ft. Minimum depth ft. Maximum depth ft.

Bottom width ft. Discharge g.p.m. Date of test

12. Tunnel: Type of lining

Dimensions:
(Length, course, and cross sectional size)

Position of water bearing stratum with reference to portal of tunnel

Log of tunnel: (Preceding table for log of well may be used, if desired. Give footage from portal and character of materials, as pertinent.)

13. Pumping Equipment:

(a) Pump Centrifugal Capacity 2.75 g.p.m.
(Make, type and size)


(b) Motor 15 Hp Electric
(Type and horsepower)

14. Location of area irrigated or to be irrigated, or place of use if for purposes other than irrigation.

Township North or South	Range E. or W. of Willamette Meridian	Section	Forty-acre Tract	Number Acres To Be Irrigated	Date of Reclamation
<u>T 1 S</u>	<u>R 10 W</u>	<u>26</u>	<u>SW 1/4 of SE 1/4</u>	<u>25.69</u> Ac	<u>1953</u>
"	"	<u>26</u>	<u>SE 1/4 of SW 1/4</u>	<u>7.00</u> Ac	"
"	"	<u>26</u>	<u>NE 1/4 of SW 1/4</u>	<u>4.00</u> Ac	"
"	"	<u>26</u>	<u>SW 1/4 of SE 1/4</u>	<u>20.33</u> Ac	"
"	"	<u>35</u>	<u>NW 1/4 of NE 1/4</u>	<u>10.00</u> Ac	"
				<u>67.02</u> Ac	"

15. If the ground water supply is supplemental to an existing water supply, identification of any application for a permit, permit, certificate or adjudicated right to appropriate water made or held by the registrant.

Township 15 Range 10 W, W.M.
North

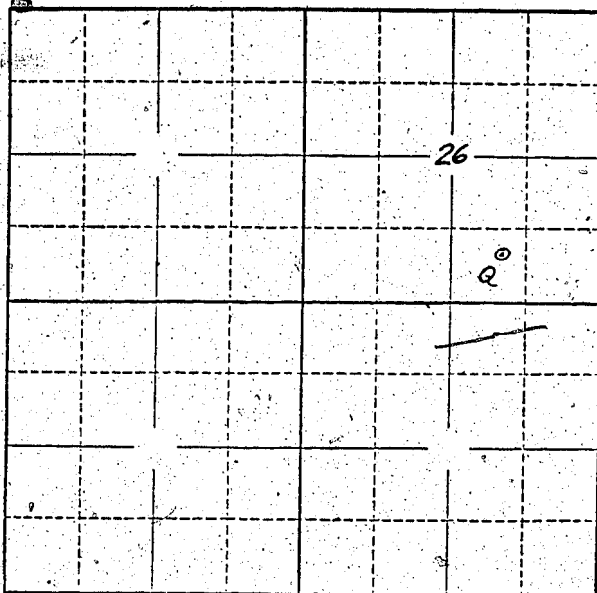

Locate well and acreage of irrigated land on plat.
Scale: 2" = 1 Mile

STATE OF OREGON

County of Tillamook } ss.

I, E. Arnold Walker, being first duly sworn, do hereby certify that I have read the foregoing Registration Statement and that all of the items therein contained are true to the best of my knowledge and belief.

E. Arnold Walker
(Signature of Registrant)

Subscribed and sworn to before me this 30th day of July, 1958

My commission expires June 8, 1959

Oliver H. Shelton
(Notary Public)

(SEAL)

CERTIFICATE OF REGISTRATION

STATE OF OREGON

County of Marion } ss.

This is to certify that the foregoing Registration Statement was received in the office of the State Engineer on the 31 day of July, 1958, at 8:00 o'clock A.M. and has been duly recorded in said office in Book No. 13 of Registration Statements on page GR 3102

Witness my hand this 16th day of June, 1959

Luiza A. Stanley
(State Engineer)

By _____ (Deputy)

GR - 3102

\$ 20.85
|
|
|