

Registration Statement

OF CLAIMANT OF RIGHT TO APPROPRIATE GROUND WATER

TO THE STATE ENGINEER OF OREGON:

I, ROY R SMITH & ROBERT HUBBARD

of RT 2 BOX 188 AURORA County of MARION

State of OREGON do hereby make application for a certificate of registration as evidence of a right to appropriate ground water.

1. Source from which water is withdrawn is A PUMP WELL
(Flowing well, pump well, infiltration trench, or tunnel)

2. Location is: 1 MILE NORTH OF BUTTEVILLE
(Approximate distance and direction from nearest city or town)

and is more particularly described as follows:

(a) 350 FEET NORTH & 680 FEET WEST FROM SE CORNER SECTION 32
(Give distance and bearing to corner of section or other legal subdivision)

being within SE 1/4 OF SE 1/4 of Sec. 32, Twp. 35, Rge. 10W
(Smallest legal subdivision) (N. or S.) (E. or W.)

or (b) within limits of recorded platted property, town or city: _____

in Lot _____, Block _____ of _____
(Name of plat or addition)

County of _____
(If within city or town, give name)

3. Construction Work was begun on JUNE 1946; was completed on JUNE 1946
(Date) (Date)

and the ground water claimed was first used for the purposes set out below on JUNE 1946
(Date)

since which time the water has been used DURING IRRIGATION SEASON
(Continuously or intermittently)

from 1946 to PRESENT 1958
(Date) (Date)

4. Quantity of water claimed and used is 175 gallons per minute; 115 acre feet per year.

5. Purpose or Purposes for which water is used IRRIGATION

(Domestic, irrigation, municipal, manufacturing, industrial, etc.)

6. Description of Well: Depth 203 feet. Type DRILLED WELL
(Dug or drilled)

diameter 6 inches. Elevation of ground at well site _____ feet, mean sea level.
(As near as known)

Depth to water table 70 feet.

7. Capacity of Well: NOT KNOWN g.p.m. with _____ feet drawdown.

_____ g.p.m. with _____ feet drawdown.


Date of test _____

If Flowing Well: Measured discharge _____ g.p.m. on _____
(Date)

Shut-in pressure at ground surface _____ lbs. per sq. in. on _____
(Date)

Water is controlled by _____
(Cap, valve, etc.)

Township 35 Range 1W W.M.
North

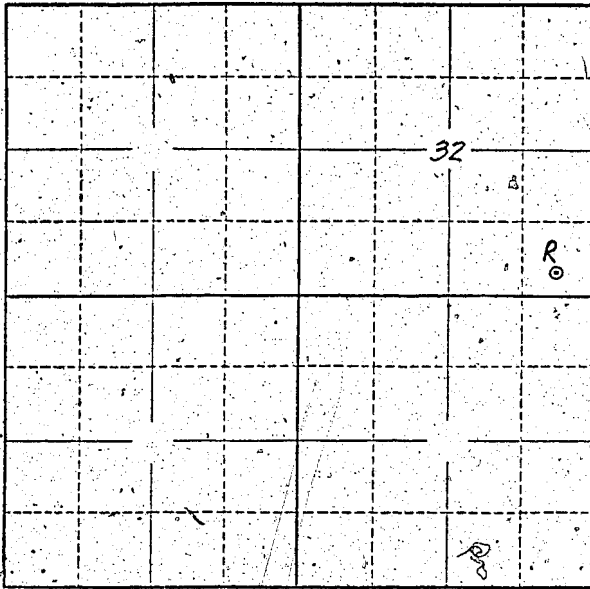

Locate well and acreage of irrigated land on plat.

Scale: 2" = 1 Mile

STATE OF OREGON

County of Clackamas } ss.
We, Roy R. Smith and Robert Hubbard, each

I, _____, being first duly sworn, do hereby certify that I have read the foregoing Registration Statement and that all of the items therein contained are true to the best of my knowledge and belief.

Roy R. Smith
Robert Hubbard
(Signature of Registrant)

Subscribed and sworn to before me this 30th day of July, 1958

My commission expires 11/22/61

James P. Bettis, Sr.
(Notary Public)

(SEAL)

CERTIFICATE OF REGISTRATION

STATE OF OREGON

County of Marion } ss.

This is to certify that the foregoing Registration Statement was received in the office of the State Engineer on the 31st day of July, 1958, at 2:00 o'clock A.M. and has been duly recorded in said office in Book No. 13 of Registration Statements on page GR 3103

Witness my hand this 16th day of June, 1959

Lewis A. Stanley
(State Engineer)

By _____
(Deputy)

GR - 3103

\$15.30