

# Registration Statement

## OF CLAIMANT OF RIGHT TO APPROPRIATE GROUND WATER

TO THE STATE ENGINEER OF OREGON:

I, Lester J. Armstrong  
of Rt. 3 Box 20 <sup>18</sup> Tillamook, Oregon County of Tillamook  
(Mailing address)

State of Oregon, do hereby make application for a certificate of registration as evidence of a right to appropriate ground water.

1. Source from which water is withdrawn is Pump Well  
(Flowing well, pump well, infiltration trench, or tunnel)

2. Location is: apprx. 1/2 mile south of Tillamook, Oregon  
(Approximate distance and direction from nearest city or town)

and is more particularly described as follows:

(a) 627 ft North and 262.0 ft east of the 1 corner between sections 31 36 Twp. 1 S.  
SW 1/4 of NW 1/4 (Give distance and bearing to corner of section or other legal subdivision) R. 9 and 10. W.W.M.  
being within Government lot 4 of Sec. 31, Twp. 1 S., Rge. 9 W.  
(Smallest legal subdivision) (N. or S.) (E. or W.)

or (b) within limits of recorded platted property, town or city:

in Lot \_\_\_\_\_, Block \_\_\_\_\_ of \_\_\_\_\_  
(Name of plat or addition)  
County of \_\_\_\_\_  
(If within city or town, give name)

3. Construction Work was begun on about Aug. 23-1953 was completed on Sept. 1-1953  
(Date) (Date)

and the ground water claimed was first used for the purposes set out below on Nov. 15-1953  
(Date)

since which time the water has been used Continuously for Domestic and Intermittently for  
(Continuously or Intermittently) Irrigation.  
from Nov. 15-1953 to Present  
(Date) (Date)

4. Quantity of water claimed and used is apprx. 260 gallons per minute; \_\_\_\_\_ acre feet per year.

5. Purpose or Purposes for which water is used (exempt) ~~irrigation and~~ irrigation  
(Domestic, irrigation, municipal, manufacturing, industrial, etc.)

6. Description of Well: Depth 106 feet. Type Drilled  
(Dug or drilled)  
diameter 8 inches. Elevation of ground at well site apprx. 15 feet, mean sea level.  
(As near as known)  
Depth to water table 3 feet.

7. Capacity of Well: 500 g.p.m. with 10 feet drawdown. no accurst test, but, as near as could measure it did at least  
\_\_\_\_\_ g.p.m. with \_\_\_\_\_ feet drawdown. least that much.

Date of test Sept. 1-1953

If Flowing Well: Measured discharge \_\_\_\_\_ g.p.m. on \_\_\_\_\_  
(Date)

Shut-in pressure at ground surface \_\_\_\_\_ lbs. per sq. in. on \_\_\_\_\_  
(Date)

Water is controlled by \_\_\_\_\_  
(Cap, valve, etc.)


**8. Casing:** (Give diameter, commercial specifications and depth below ground surface of each casing size.)

8 inch diameter ..... from 0 to 155 feet  
 ..... inch diameter ..... from ..... to ..... feet  
 ..... inch diameter ..... from ..... to ..... feet  
 ..... inch diameter ..... from ..... to ..... feet

Describe and show depth of shoe, plug, adapter, liner or other details: Domestic pump 21' irrigation pump 22' feet intake pipe down in well.

**9. Perforated Casings or Screens:** It is perforated but I do not know the size and how many.

(Number per foot and size of perforations, or describe)

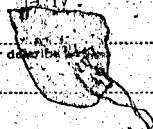

..... from ..... to .....  
 ..... from ..... to .....  
 ..... from ..... to .....  
 ..... from ..... to .....

**10. Log of Well:** (Describe each stratum or formation clearly, indicate if water bearing, and give thickness and depth as indicated.) I have no log on the well.

MATERIAL	Thickness (Feet)	Depth to Bottom (Feet)

If log of well is not available, give name and address of driller. Paul Ross Alton, Oregon.

11. Infiltration Trench: Covered or open .....

Dimensions: Length ..... ft. Minimum depth ..... ft. Maximum depth ..... ft.

Bottom width ..... ft. Discharge ..... g.p.m. Date of test .....

12. Tunnel: Type of lining .....

Dimensions: .....  
(Length, course, and cross sectional size)

Position of water bearing stratum with reference to portal of tunnel .....

Log of tunnel: (Preceding table for log of well may be used, if desired. Give footage from portal and character of materials, as pertinent.)

13. Pumping Equipment:

Domestic Centrifical 1 inch outlet 1. intake 30# pressure 2000

(a) Pump Hyss irrigation 2 inch outlet 4 intake Capacity 208 g.p.m.  
(Make, type and size)


(b) Motor Arrigation 5 horse single phase Domestic 3 horse 3 phase  
(Type and horsepower)

14. Location of area irrigated or to be irrigated, or place of use if for purposes other than irrigation.

Township North or South	Range E. or W. of Willamette Meridian	Section	Forty-acre Tract	Number Acres To Be Irrigated	Date of Reclamation
1-S	9W	31 <del>111A</del>	SW $\frac{1}{4}$ of NW $\frac{1}{4}$	29	1953

15. If the ground water supply is supplemental to an existing water supply, identification of any application for a permit, permit, certificate or adjudicated right to appropriate water made or held by the registrant.

Township 15 Range 9W W.M.  
North

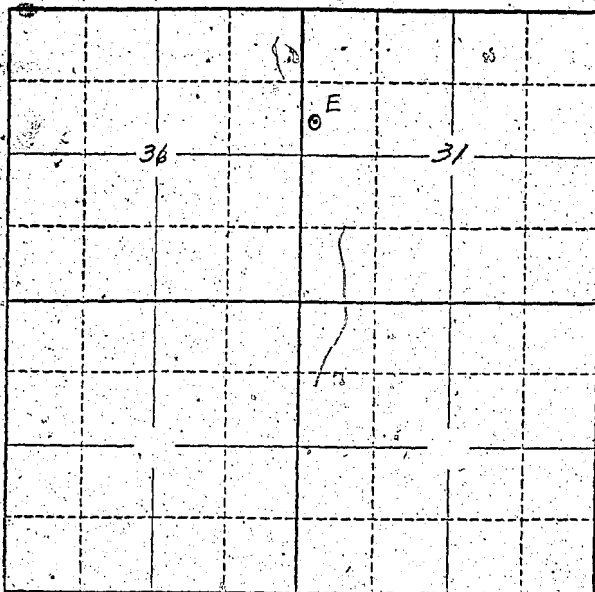

Locate well and acreage of irrigated land on plat.  
Scale: 2" = 1 Mile

STATE OF OREGON

County of Linn } ss.

I, [Signature], being first duly sworn, do hereby certify that I have read the foregoing Registration Statement and that all of the items therein contained are true to the best of my knowledge and belief.

(Signature of Registrant)

Subscribed and sworn to before me this 30th day of July, 1958

My commission expires Oct. 17, 1960

(Notary Public)

(SEAL)

### CERTIFICATE OF REGISTRATION

STATE OF OREGON

County of Marion } ss.

This is to certify that the foregoing Registration Statement was received in the office of the State Engineer on the 31 day of July, 1958, at 8:00 o'clock A.M. and has been duly recorded in said office in Book No. 13 of Registration Statements on page GR-3104

Witness my hand this 16th day of June, 1959

(State Engineer)

By [Signature]  
(Deputy)