

RECEIVED

JAN 17 1957

STATE ENGINEER  
SALEM, OREGON

REGISTRATION NO. GR-336

Registration Statement CERTIFICATE NO. GR-321

OF CLAIMANT OF RIGHT TO APPROPRIATE GROUND WATER

(Under Chapter 708, Oregon Laws 1955.)

TO THE STATE ENGINEER OF OREGON:

I, Ruth Cobb and Elmer O. and Jennie Chambers  
of Rt. 2, Box 358, Albany County of Linn

State of Oregon, do hereby make application for a certificate of registration as evidence of a right to appropriate ground water.

- 1. Source from which water is withdrawn is Pump well No. 3  
(Flowing well, pump well, infiltration trench, or tunnel)
- 2. Location is: 10 miles north of Albany, Oregon  
(Approximate distance and direction from nearest city or town)

and is more particularly described as follows:

(a) S. 21° 05' W. 30.25 chains from the NE corner of NW 1/4, S. 4, T. 10 S., R. 3 W.W.M.  
(Give distance and bearing to corner of section or other legal subdivision)  
being within SE 1/4 of NW 1/4 of Sec. 4, Twp. 10 S, Rge. 3 W  
(Smallest legal subdivision) (N. or S.) (E. or W.)

or (b) within limits of recorded platted property, town or city: \_\_\_\_\_  
in Lot \_\_\_\_\_, Block \_\_\_\_\_ of \_\_\_\_\_  
(Name of plat or addition)

County of Linn  
(If within city or town, give name)

3. Construction Work was begun on April 20, 1950; was completed on April 21, 1950  
(Date) (Date)

and the ground water claimed was first used for the purposes set out below on \_\_\_\_\_  
(Date)

since which time the water has been used continuously  
(Continuously or Intermittently)

from June 5, 1950 to present time  
(Date) (Date)

4. Quantity of water claimed and used is 420 gallons per minute; 73.5 acre feet per year.

5. Purpose or Purposes for which water is used irrigation  
(Domestic, irrigation, municipal, manufacturing, industrial, etc.)

6. Description of Well: Depth 35 feet. Type drilled  
(Dug or drilled)  
diameter 8 inches. Elevation of ground at well site 190 feet, mean sea level.  
(As near as known)  
Depth to water table 8 feet.

7. Capacity of Well: 500 g.p.m. with 10 feet drawdown.  
\_\_\_\_\_ g.p.m. with \_\_\_\_\_ feet drawdown.

Date of test Not tested

If Flowing Well: Measured discharge \_\_\_\_\_ g.p.m. on \_\_\_\_\_  
(Date)

Shut-in pressure at ground surface \_\_\_\_\_ lbs. per sq. in. on \_\_\_\_\_  
(Date)

Water is controlled by \_\_\_\_\_  
(Cap, valve, etc.)

8. Casing: (Give diameter, commercial specifications and depth below ground surface of each casing size.)

10 inch diameter steel casing from 0 to 32 feet  
inch diameter from to feet  
inch diameter from to feet  
inch diameter from to feet

Describe and show depth of shoe, plug, adapter, liner or other details:

9. Perforated Casings or Screens:

slit perforations from 24 to 32  
(Number per foot and size of perforations, or describe screen)  
from to  
from to  
from to

10. Log of Well: (Describe each stratum or formation clearly, indicate if water bearing, and give thickness and depth as indicated.)

MATERIAL	Thickness (Feet)	Depth to Bottom (Feet)
Not available		

If log of well is not available, give name and address of driller. Bill Hamilton well Drilling Co.,  
838 E. 3rd Ave., Albany, Oregon

11. Infiltration Trench: Covered or open .....

Dimensions: Length ..... ft. Minimum depth ..... ft. Maximum depth ..... ft.

Bottom width ..... ft. Discharge ..... g.p.m. Date of test .....

12. Tunnel: Type of lining .....

Dimensions: .....  
(Length, course, and cross sectional size)

Position of water bearing stratum with reference to portal of tunnel .....

Log of tunnel: (Preceding table for log of well may be used, if desired. Give footage from portal and character of materials, as pertinent.)

13. Pumping Equipment:

(a) Pump Allis Chalmers 2 $\frac{1}{2}$ " centrifugal Capacity 450 g.p.m.  
(Make, type and size)


(b) Motor 15 H. P. electric  
(Type and horsepower)

14. Location of area irrigated or to be irrigated, or place of use if for purposes other than irrigation.

Township North or South	Range E. or W. of Willamette Meridian	Section	Forty-acre Tract	Number Acres To Be Irrigated	Date of Reclamation
10 S	3 W.	4	NE $\frac{1}{4}$ of SW $\frac{1}{4}$	5.0	June 5, 1950
10 S	3 W.	4	SE $\frac{1}{4}$ of NW $\frac{1}{4}$	16.0	June 5, 1950
10 S	3 W.	4	NE $\frac{1}{4}$ of NW $\frac{1}{4}$	8.4	June 5, 1950
				29.4	

15. If the ground water supply is supplemental to an existing water supply, identification of any application for a permit, permit, certificate or adjudicated right to appropriate water made or held by the registrant.

Township 10 S Range 3 W. W.M.  
North

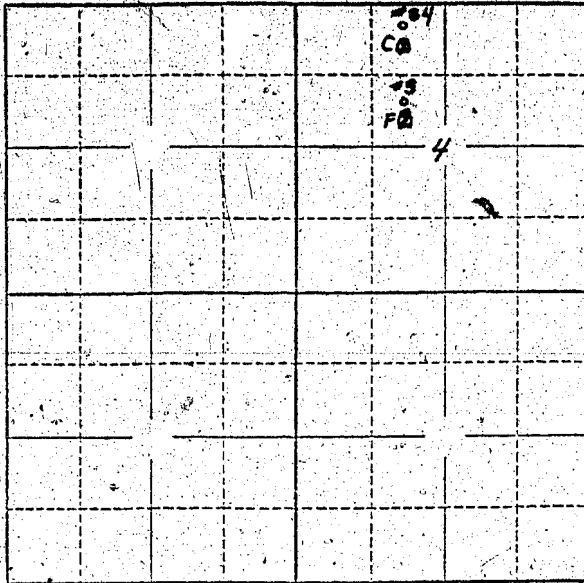

Locate well and acreage of irrigated land on plat.  
Scale: 2" = 1 Mile

STATE OF OREGON

County of Linn } ss.  
Ruth Cobb and Elmer C.

I, Jennie Chambers, being first duly sworn, do hereby certify that I have read the foregoing Registration Statement and that all of the items therein contained are true to the best of my knowledge and belief.

*Jennie Chambers Ruth Cobb*  
(Signature of Registrant)

Subscribed and sworn to before me this \_\_\_\_\_ day of \_\_\_\_\_, 19\_\_\_\_

My commission expires \_\_\_\_\_ (Notary Public)

(SEAL)

See Page GR-321 G For  
CERTIFICATE OF REGISTRATION

STATE OF OREGON } ss.  
County of Marion

~~This is to certify that the foregoing Registration Statement was received in the office of the State Engineer on the \_\_\_\_\_ day of \_\_\_\_\_, 19\_\_\_\_ at \_\_\_\_\_ and has been duly recorded in said office in Book No. \_\_\_\_\_ of Registration Statements on pages \_\_\_\_\_~~

~~Construction shall be completed by \_\_\_\_\_ 19\_\_\_\_ and the water completely applied to beneficial use by \_\_\_\_\_ 19\_\_\_\_~~

~~Witness my hand this \_\_\_\_\_ day of \_\_\_\_\_ 19\_\_\_\_~~

\_\_\_\_\_  
(State Engineer)

By \_\_\_\_\_  
(Deputy)

GR-321C

RECEIVED

JAN 17 1957  
STATE ENGINEER  
SALEM, OREGON

Registration Statement

REGISTRATION NO. R-336  
CERTIFICATE NO. R-321

OF CLAIMANT OF RIGHT TO APPROPRIATE GROUND

(Under Chapter 708, Oregon Laws 1955.)

TO THE STATE ENGINEER OF OREGON:

Ruth Cobb and Elmer C. and Jennie Chambers  
of Rt. 2, Box 358, Albany County of Linn

State of Oregon do hereby make application for a certificate of registration as evidence of a right to appropriate ground water.

- 1. Source from which water is withdrawn is pump well No. 4  
(Flowing well, pump well, infiltration trench, or tunnel)
- 2. Location is: 10 miles north of Albany, Oregon  
(Approximate distance and direction from nearest city or town)

and is more particularly described as follows:

(a) S. 75° W. 12 chains from the NE corner of NW 1/4, S. 4, T. 10 S., R. 3 W.W.M.  
(Give distance and bearing to corner of section or other legal subdivision)  
being within NE 1/4 of NW 1/4 of Sec. 4, Twp. 10 S, Rge. 3 W.  
(Smallest legal subdivision) (N. or S.) (E. or W.)

or (b) within limits of recorded platted property, town or city: \_\_\_\_\_  
in Lot \_\_\_\_\_, Block \_\_\_\_\_ of \_\_\_\_\_  
(Name of plat or addition)

County of Linn  
(If within city or town, give name)

3. Construction Work was begun on April 14, 1950; was completed on April 20, 1950  
(Date) (Date)  
and the ground water claimed was first used for the purposes set out below on June 10, 1950  
(Date)

since which time the water has been used continuously  
(Continuously or intermittently)  
from June 10, 1950 to present time  
(Date) (Date)

4. Quantity of water claimed and used is 300 gallons per minute; 67.5 acre feet per year.

5. Purpose or Purposes for which water is used Irrigation  
(Domestic, irrigation, municipal, manufacturing, industrial, etc.)

6. Description of Well: Depth 25 feet. Type driven  
(Dug or drilled)  
diameter 6 inches. Elevation of ground at well site 190 feet, mean sea level.  
(As near as known)  
Depth to water table 12 feet.

7. Capacity of Well: 325 g.p.m. with 8 feet drawdown.  
\_\_\_\_\_ g.p.m. with \_\_\_\_\_ feet drawdown.

Date of test Not tested

If Flowing Well: Measured discharge \_\_\_\_\_ g.p.m. on \_\_\_\_\_  
(Date)

Shut-in pressure at ground surface \_\_\_\_\_ lbs. per sq. in. on \_\_\_\_\_  
(Date)

Water is controlled by \_\_\_\_\_  
(Cap, valve, etc.)

GR-321 D

8. **Casing:** (Give diameter, commercial specifications and depth below ground surface of each casing size.)

5 inch diameter steel casing from 0 to 25 feet  
 inch diameter from to feet  
 inch diameter from to feet  
 inch diameter from to feet

Describe and show depth of shoe, plug, adapter, liner or other details:  
 .....  
 .....

9. **Perforated Casings or Screens:**

slit perforations from 17 to 25  
(Number per foot and size of perforations, or describe screen)  
 from to  
 from to  
 from to

10. **Log of Well:** (Describe each stratum or formation clearly, indicate if water bearing, and give thickness and depth as indicated.)

MATERIAL	Thickness (Feet)	Depth to Bottom (Feet)
Not available		

GR-321E

If log of well is not available, give name and address of driller. .... driven

11. Infiltration Trench: Covered or open .....

Dimensions: Length ..... ft. Minimum depth ..... ft. Maximum depth ..... ft.

Bottom width ..... ft. Discharge ..... g.p.m. Date of test .....

12. Tunnel: Type of lining .....

Dimensions: .....  
(Length, course, and cross sectional size)

Position of water bearing stratum with reference to portal of tunnel .....

Log of tunnel: (Preceding table for log of well may be used, if desired. Give footage from portal and character of materials, as pertinent.)

13. Pumping Equipment:

(a) Pump Allis Chalmers 2<sup>n</sup> centrifugal ..... Capacity 350 ..... g.p.m.  
(Make, type and size)


(b) Motor 10 H. P. electric .....  
(Type and horsepower)

14. Location of area irrigated or to be irrigated, or place of use if for purposes other than irrigation.

Township North or South	Range E. or W. of Willamette Meridian	Section	Forty-acre Tract	Number Acres To Be Irrigated	Date of Reclamation
10 S	3 W.	4	NE $\frac{1}{4}$ of NW $\frac{1}{4}$	14.0	June 10, 1950
9 S	3 W.	33	SE $\frac{1}{4}$ of SW $\frac{1}{4}$	13.0	June 10, 1950
				27.0	

15. If the ground water supply is supplemental to an existing water supply, identification of any application for a permit, permit, certificate or adjudicated right to appropriate water made or held by the registrant.

Township ~~10~~ <sup>10</sup> Range ~~2 W.~~ <sup>2 W.</sup>, W.M.  
North

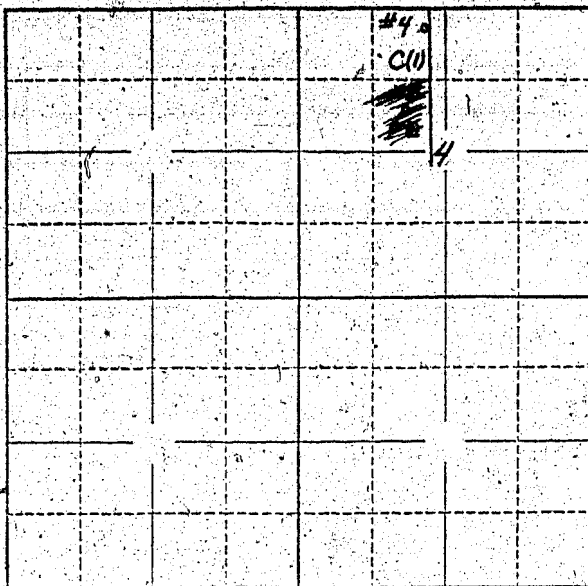

See map in  
file GR-336

Locate well and acreage of irrigated land on plat.

Scale: 2" = 1 Mile

STATE OF OREGON

County of Linn } ss.

Ruth Cobb and Elmer and

Jennie Chambers

, being first duly sworn, do hereby certify that I have read the foregoing Registration Statement and that all of the items therein contained are true, to the best of my knowledge and belief.

*Elmer C. Chambers, Jennie Chambers, Ruth Cobb*  
(Signature of Registrant)

Subscribed and sworn to before me this 14th day of January, 1957.

My commission expires April 1, 1959  
(Notary Public)

(SEAL)

**CERTIFICATE OF REGISTRATION**

STATE OF OREGON

County of Marion } ss.

This is to certify that the foregoing Registration Statement was received in the office of the State Engineer on the 17th day of January, 1957, at 8:00 o'clock A.M. and has been duly recorded in said office in Book No. 2 of Registration Statements on page GR-321 G.

Construction shall be completed by ~~XXXXXX~~ 10 and the water completely applied to beneficial use by ~~XXXXXX~~ 10.

Witness my hand this 1st day of April, 1957.

*Laura A. Stanley*  
(State Engineer)

By \_\_\_\_\_ (Deputy)

GR-321 G

#1905