

Registration Statement

OF CLAIMANT OF RIGHT TO APPROPRIATE GROUND WATER

TO THE STATE ENGINEER OF OREGON:

I, Chester Fraker

of 1361 Kings Highway, Medford County of Jackson
(Mailing address)

State of Oregon, do hereby make application for a certificate of registration as evidence of a right to appropriate ground water:

1. Source from which water is withdrawn is Pump Well
(Flowing well, pump well, infiltration trench, or tunnel)

2. Location is: 3 1/2 miles SW of Medford, Oregon
(Approximate distance and direction from nearest city or town)

and is more particularly described as follows:

(a) 1104 feet North and 652 feet West from the SE corner of DIC #40
(Give distance and bearing to corner of section or other legal subdivision)
being within SW, SE, NE of Sec. 2, Twp. 38 S., Rge. 2
(Smallest legal subdivision) (N. or S.) (E. or W.)

or (b) within limits of recorded platted property, town or city:

in Lot _____, Block _____ of _____
(Name of plat or addition)
County of _____
(If within city or town, give name)

3. Construction Work was begun on 1948; was completed on 1948
(Date) (Date)

and the ground water claimed was first used for the purposes set out below on 1949
(Date)

since which time the water has been used continuously
(Continuously or intermittently)

from 1949 to present
(Date) (Date)

4. Quantity of water claimed and used is 40 gallons per minute; 18 acre feet per year.

5. Purpose or Purposes for which water is used irrigation
(Domestic, irrigation, municipal, manufacturing, industrial, etc.)

6. Description of Well: Depth 12 feet. Type: dug
(Dug or drilled)

diameter 4' x 4' inches. Elevation of ground at well site 1530 feet, mean sea level.
(As near as known)

Depth to water table 3.0 feet.

7. Capacity of Well: _____ g.p.m. with _____ feet drawdown.

_____ g.p.m. with _____ feet drawdown.

Date of test _____

If Flowing Well: Measured discharge _____ g.p.m. on _____
(Date)

Shut-in pressure at ground surface _____ lbs. per sq. in. on _____
(Date)

Water is controlled by _____
(Cap, valve, etc.)

8. Casing: (Give diameter, commercial specifications and depth below ground surface of each casing size.)

4' x 4' inch diameter cased with wood planking from 0 to 8 feet
 inch diameter none from 8 to 12 feet
 inch diameter from to feet
 inch diameter from to feet

Describe and show depth of shoe, plug, adapter, liner or other details:

9. Perforated Casings or Screens:

(Number per foot and size of perforations, or describe screen) from to
 from to
 from to
 from to

10. Log of Well: (Describe each stratum or formation clearly, indicate if water bearing, and give thickness and depth as indicated.)

MATERIAL	Thickness (Feet)	Depth to Bottom (Feet)
free top soil	6	6
medium gravel (water bearing)	6	0

If log of well is not available, give name and address of driller.

11. Infiltration Trench: Covered or open
Dimensions: Length ft. Minimum depth ft. Maximum depth ft.
Bottom width ft. Discharge g.p.m. Date of test

12. Tunnel: Type of lining
Dimensions:
(Length, course, and cross sectional size)
Position of water bearing stratum with reference to portal of tunnel

Log of tunnel: (Preceding table for log of well may be used, if desired. Give footage from portal and character of materials, as pertinent.)


13. Pumping Equipment:
(a) Pump $1\frac{1}{2}$ " x $1\frac{1}{4}$ " centrifugal pump (Masters) Capacity 40 g.p.m.
(b) Motor 2.0 H.P. electric motor
(Type and horsepower)

14. Location of area irrigated or to be irrigated, or place of use if for purposes other than irrigation.

Township North or South	Range E. or W. of Willamette Meridian	Section	Forty-acre Tract	Number Acres To Be Irrigated	Date of Reclamation
38 S.	2 W.	2	SE $\frac{1}{4}$ SW $\frac{1}{4}$ NE $\frac{1}{4}$	0.5	1949
"	"	"	SW $\frac{1}{4}$ SE $\frac{1}{4}$ NE $\frac{1}{4}$	1.0	1949
"	"	"	NE $\frac{1}{4}$ NW $\frac{1}{4}$ SE $\frac{1}{4}$	0.8	1949
"	"	"	NW $\frac{1}{4}$ NE $\frac{1}{4}$ SE $\frac{1}{4}$	1.7	1949
			Total	4.0 acres	"

15. If the ground water supply is supplemental to an existing water supply, identification of any application for a permit, permit, certificate or adjudicated right to appropriate water made or held by the registrant: none

Township 38 S. Range 2 W., W.M.
North

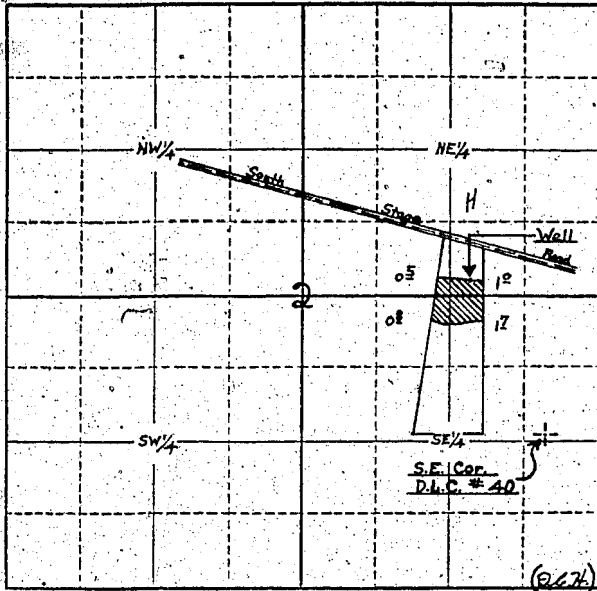

Locate well and acreage of irrigated land on plat.
Scale: 4" = 1 Mile

STATE OF OREGON }
County of Jackson } ss.

I, Chester Fraker, being first duly sworn, do hereby certify that I have read the foregoing Registration Statement and that all of the items therein contained are true to the best of my knowledge and belief.

Chester Fraker
(Signature of Registrant)

Subscribed and sworn to before me this 30th day of July, 1958.

My commission expires August 25, 1958.

[Signature]
(Notary Public)

(SEAL)

CERTIFICATE OF REGISTRATION

STATE OF OREGON }
County of Marion } ss.

This is to certify that the foregoing Registration Statement was received in the office of the State Engineer on the 31st day of July, 1959, at 8:00 o'clock A.M. and has been duly recorded in said office in Book No. 13 of Registration Statements on page GR-3113

Witness my hand this 16th day of June, 1959.

Lewis A. Stanley
(State Engineer)

By _____
(Deputy)

#15.00