

Registration Statement

GR-3365
GR-3111

OF CLAIMANT OF RIGHT TO APPROPRIATE GROUND WATER

(Under Chapter 708, Oregon Laws 1955.)

TO THE STATE ENGINEER OF OREGON:

I, Lloyd I. Palen
of Central Point County of Jackson

State of Oregon, do hereby make application for a certificate of registration as evidence of a right to appropriate ground water.

1. Source from which water is withdrawn is Pump Well
(Flowing well, pump well, infiltration trench, or tunnel)

2. Location is: 1 mile south and east of Central Point, Oregon
(Approximate distance and direction from nearest city or town)

and is more particularly described as follows: 150 ft. North & 1400 feet west from E 1/4 corner Section 11.

(a) 150' N. & 150' W. from the SE Cor. of lot 17 of Pitt View Subdivision Amended
(Give distance and bearing to corner of section or other legal subdivision)

being within SW 1/4 NE 1/4 of Sec. 11, Twp. 37 S., Rge. 2 W.
(Smallest legal subdivision) (N. or S.) (E. or W.)

or (b) within limits of recorded platted property, town or city:

in Lot 17, Block _____ of Pitt View Subdivision Amended
(Name of plat or addition)

County of Jackson
(If within city or town, give name)

3. Construction Work was begun on August 1939; was completed on August 1939
(Date) (Date)

and the ground water claimed was first used for the purposes set out below on August 1939
(Date)

since which time the water has been used Continuously
(Continuously or intermittently)

from August 1939 to Per
(Date) (Date)

4. Quantity of water claimed and used is 16 gallons per minute; 8.0 acre feet per year.

5. Purpose or Purposes for which water is used Domestic Irrigation

(Domestic, irrigation, municipal, manufacturing, industrial, etc.)

6. Description of Well: Depth 20 feet. Type Dug
(Dug or drilled)

diameter 2 inches. Elevation of ground at well site 1300 feet, mean sea level.
(As near as known)

Depth to water table 9 sump feet.

7. Capacity of Well: 66 g.p.m. with 5 feet drawdown.

_____ g.p.m. with _____ feet drawdown.


Date of test _____

If Flowing Well: Measured discharge _____ g.p.m. on _____
(Date)

Shut-in pressure at ground surface _____ lbs. per sq. in. on _____
(Date)

Water is controlled by _____
(Cap. valve, etc.)

Township 37S Range 24 W.M.
North

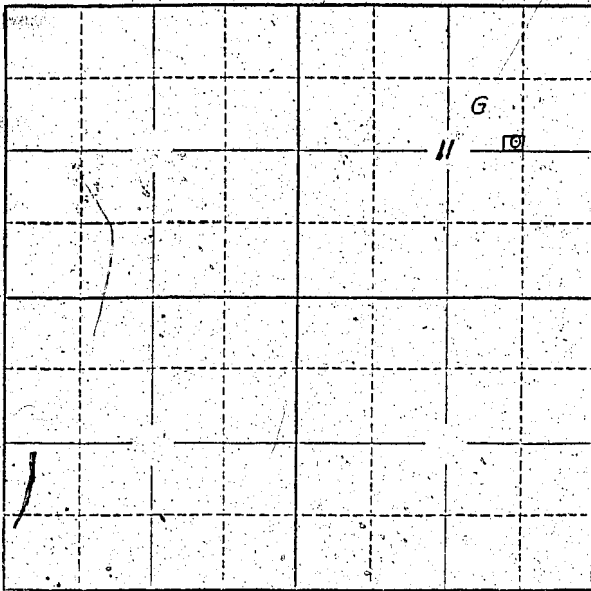

Locate well and acreage of irrigated land on plat.
Scale: 2" = 1 Mile

STATE OF OREGON

County of Jackson

ss.

I, Lloyd I. Palen, being first duly sworn, do hereby certify that I have read the foregoing Registration Statement and that all of the items therein contained are true to the best of my knowledge and belief.

Lloyd I. Palen
(Signature of Registrant)

Subscribed and sworn to before me this 30th day of July, 1958.

My commission expires August 25, 1958.

[Signature]
(Notary Public)

(SEAL)

CERTIFICATE OF REGISTRATION

STATE OF OREGON

County of Marion

ss.

This is to certify that the foregoing Registration Statement was received in the office of the State Engineer on the 31st day of July, 1952, at 2:00 o'clock A.M. and has been duly recorded in said office in Book No. 13 of Registration Statements on page GR-3114.

~~Construction shall be completed by _____ and the water completely applied to beneficial use by _____.~~

Witness my hand this 16th day of June, 1959.

[Signature]
(State Engineer)

By _____

(Deputy)

GR-3114

\$ 15.00