

Registration Statement

OF CLAIMANT OF RIGHT TO APPROPRIATE GROUND WATER

This statement is being filed in lieu of an original statement that has been ~~misplaced~~ misplaced or lost. Original statement filed Aug 1st 1958.

TO THE STATE ENGINEER OF OREGON:

I, Larry Lee Espe
of Rt 2 Box 4 Silverton County of Harrison
State of Oregon, do hereby make application for a certificate of registration as evidence of a right to appropriate ground water.

1. Source from which water is withdrawn is Pump well
(Flowing well, pump well, infiltration trench, or tunnel)

2. Location is: 2 miles west of Silverton
(Approximate distance and direction from nearest city or town)

and is more particularly described as follows:

(a) 2740 feet north and 3370 feet east to NE corner of sec
(Give distance and bearing to corner of section or other legal subdivision)

being within NE 1/4 of SW 1/4 of Sec. 28, Twp. 6 S, Rge. 1 W
(Smallest legal subdivision) (Twp. S.) (Rge. W.)

or (b) within limits of recorded platted property, town or city:

in Lot _____ Block _____ of _____
(Name of plat or addition)

County of _____
(If within city or town, give name)

3. Construction Work was begun on Spring 1954; was completed on late Spring 1954
(Date) (Date)

and the ground water claimed was first used for the purposes set out below on fall 1954
(Date)

since which time the water has been used intermittently every summer
(Continuously or intermittently)
from 1954 to 1958
(Date) (Date)

4. Quantity of water claimed and used is 150 gallons per minute; 7 acre feet per year.

5. Purpose or Purposes for which water is used irrigation
(Domestic, irrigation, municipal, manufacturing, industrial, etc.)

6. Description of Well: Depth 117 feet. Type hand-dug
(Dug or drilled)

diameter 8 inches. Elevation of ground at well site unk feet, mean sea level.
(As near as known)

Depth to water table _____ feet.

7. Capacity of Well: unk g.p.m. with unk feet drawdown.

_____ g.p.m. with _____ feet drawdown.

Date of test 2/25/58

If Flowing Well: Measured discharge _____ g.p.m. on _____
(Date)

Shut-in pressure at ground surface _____ lbs. per sq. in. on _____
(Date)

Water is controlled by _____
(Cap. valve, etc.)

unknown

8. Casing: (Give diameter, commercial specifications and depth below ground surface of each casing size.)

..... inch diameter from to feet
..... inch diameter from to feet
..... inch diameter from to feet
..... inch diameter from to feet

Describe and show depth of shoe, plug, adapter, liner or other details:

.....
.....
.....

9. Perforated Casings or Screens:

unk from to
(Number per foot and size of perforations, or describe screen)
..... from to
..... from to
..... from to

10. Log of Well: (Describe each stratum or formation clearly, indicate if water bearing, and give thickness and depth as indicated.)

| MATERIAL | Thickness (Feet) | Depth to Bottom (Feet) |
|------------|------------------|------------------------|
| <i>unk</i> | | |
| | | |
| | | |
If log of well is not available, give name and address of driller: Stadler Stahl & Co.
drilling, Silverton, Oregon

11. Infiltration-Trench: Covered or open

Dimensions: Length ft. Minimum depth ft. Maximum depth ft.

Bottom width ft. Discharge g.p.m. Date of test

12. Tunnel: Type of lining

Dimensions:
(Length, course, and cross sectional size)

Position of water bearing stratum with reference to portal of tunnel

Log of tunnel: (Preceding table for log of well may be used, if desired. Give footage from portal and character of materials, as pertinent.)

13. Pumping Equipment:

(a) Pump: turbine 5 horse Capacity 90-100 g.p.m.
(Make, type and size)


(b) Motor: 5 horse electric
(Type and horsepower)

14. Location of area irrigated or to be irrigated, or place of use if for purposes other than irrigation.

| Township North or South | Range E. or W. of Willamette Meridian | Section | Forty-acre Tract | Number Acres To Be Irrigated | Date of Reclamation |
|-------------------------|---------------------------------------|---------|-----------------------------|------------------------------|---------------------|
| T6S | R1W | 28 | SW 1/4 of SW 1/4 | 9.0 | 1954 |
| " | " | " | NE 1/4 of the SW 1/4 | 9.0 | 1954 |
| | | | | | |
| | | | | | |
15. If the ground water supply is supplemental to an existing water supply, identification of any application for a permit, permit, certificate or adjudicated right to appropriate water made or held by the registrant.

Township 6 S Range 1 W W.M. Sec 28
North

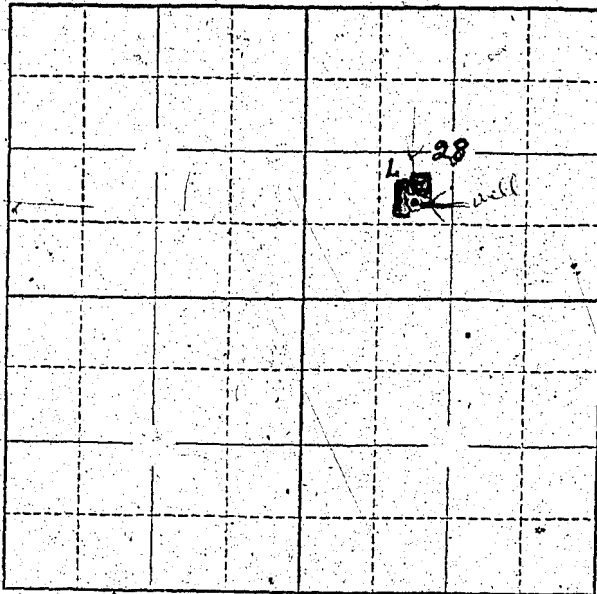

Locate well and acreage of irrigated land on plat.
Scale: 2" = 1 Mile

STATE OF OREGON

County of Marion } ss.

I Gary Lee Espe, being first duly sworn, do hereby certify that I have read the foregoing Registration Statement and that all of the items therein contained are true to the best of my knowledge and belief.

Gary Lee Espe
(Signature of Registrant)

Subscribed and sworn to before me this 20th day of June, 1967

My commission expires
NOTARY PUBLIC FOR OREGON
MY COMMISSION EXPIRES JAN. 18, 1966

[Signature]
(Notary Public)

(SEAL)

CERTIFICATE OF REGISTRATION

STATE OF OREGON } ss.
County of Marion

This is to certify that the foregoing ^{original} Registration Statement was received in the office of the State Engineer on the 1st day of August, 1958, at 8⁰⁰ o'clock A. M. and has been duly recorded in said office in Book No. 17 of Registration Statements on page GR-4124

Witness my hand this 25th day of June, 1967

\$15.00

[Signature]
(State Engineer)

By _____ (Deputy)

GR 4124