

Registration Statement

OF CLAIMANT OF RIGHT TO APPROPRIATE GROUND WATER

TO THE STATE ENGINEER OF OREGON:

I, Wesley Bondy

of Madras County of M

(Mailing address)

State of Oregon, do hereby make application for a certificate of registration as evidence of a right to appropriate ground water.

1. Source from which water is withdrawn is 11104 well
(Flowing well, pump well, infiltration trench, or tunnel)

2. Location is: about one-half mile west of east boundary more about 2000 ft.
(Approximate distance and direction from nearest city or town)

and is more particularly described as follows: 1150 South & 90 feet east from NW corner Section 2,

(a) being within NW 1/4 of SW 1/4 of Sec. 2, Twp. 5 S., Rge. 2 E.
(Give distance and bearing to corner of section or other legal subdivision)
(Smallest legal subdivision) (N. or S.) (E. of W.)

or (b) within limits of recorded platted property, town or city: Block of Madras
in Lot 1, Block 1 of Madras
(Name of plat or addition)

(If within city or town, give name)

County of Madras

X 3. Construction Work was begun on 12-15-1953; was completed on 12-22-1953
(Date) (Date)

and the ground water claimed was first used for the purposes set out below on 12-22-1953
(Date)

since which time the water has been used Continuously
(Continuously or Intermittently)

from 12-25 to Perpetual Time
(Date) (Date)

4. Quantity of water claimed and used is 125 gallons per minute; 6 acre feet per year.

5. Purpose or Purposes for which water is used Domestic

(Domestic, irrigation, municipal, manufacturing, industrial, etc.)

6. Description of Well: Depth 162 feet. Type Dug
(Dug or drilled)

diameter 8 inches. Elevation of ground at well site 171 feet, mean sea level.
(As near as known)

Depth to water table 20 feet.

7. Capacity of Well: 125 g.p.m. with 162 feet drawdown.

1 g.p.m. with 1 feet drawdown.

Date of test December 15, 1953

If Flowing Well: Measured discharge 125 g.p.m. on 12-15-1953
(Date)

Shut-in pressure at ground surface 1.5 lbs. per sq. in. on 12-15-1953
(Date)

Water is controlled by Cap, valve, etc.
(Cap, valve, etc.)

8. Casing: (Give diameter, commercial specifications and depth below ground surface of each casing size.)

3.8 inch diameter Steel Casing from top to 100 feet
 inch diameter from to feet
 inch diameter from to feet
 inch diameter from to feet

Describe and show depth of shoe, plug, adapter, liner or other details:

9. Perforated Casings or Screens:

Perforated size 10 Perforations per foot 1 3/4 inch from 50 to 160 feet
 (Number per foot and size of perforations, or describe screen)
 from to
 from to
 from to

10. Log of Well: (Describe each stratum or formation clearly, indicate if water bearing, and give thickness and depth as indicated.)

MATERIAL	Thickness (Feet)	Depth to Bottom (Feet)

If log of well is not available, give name and address of driller.

11. Infiltration Trench: Covered or open

Dimensions: Length ft. Minimum depth ft. Maximum depth ft.

Bottom width ft. Discharge g.p.m. Date of test

12. Tunnel: Type of lining

Dimensions:
(Length, course, and cross sectional size)

Position of water bearing stratum with reference to portal of tunnel

Log of tunnel: (Preceding table for log of well may be used, if desired. Give footage from portal and character of materials, as pertinent.)

13. Pumping Equipment:

(a) Pump Capacity 160 g.p.m.
(Make; type and size)


(b) Motor
(Type and horsepower)

14. Location of area irrigated or to be irrigated, or place of use if for purposes other than irrigation.

Township North or South	Range E. or W. of Willamette Meridian	Section	Forty-acre Tract	Number Acres To Be Irrigated	Date of Reclamation
T5S	R2W	2	NW ¹ / ₄ of SW ¹ / ₄	3.5	Nov. 1953
"	"	2	SW ¹ / ₄ of SW ¹ / ₄	1.2	"
"	"	3	NE ¹ / ₄ of SE ¹ / ₄	1.5	"
				<u>6.0</u> Ac	"

15. If the ground water supply is supplemental to an existing water supply, identification of any application for a permit, permit, certificate or adjudicated right to appropriate water made or held by the registrant.

Township 55 Range 2W, W.M.
North

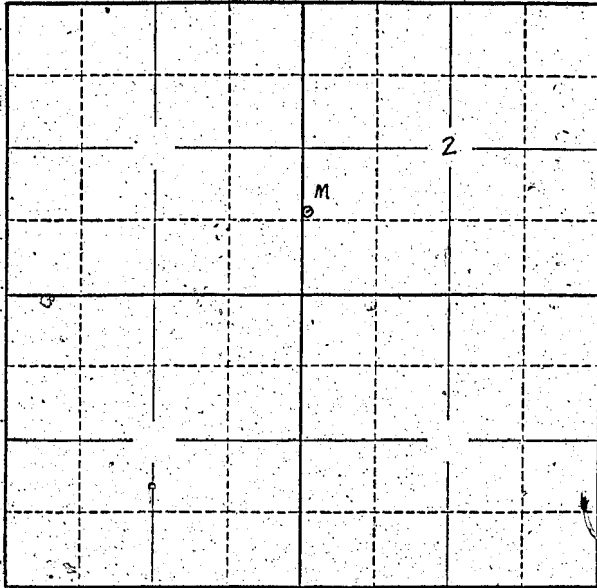

Locate well and acreage of irrigated land on plat.
Scale: 2" = 1 Mile

STATE OF OREGON

County of _____ } ss.

I, Vasili Kononov, being first duly sworn, do hereby certify that I have read the foregoing Registration Statement and that all of the items therein contained are true to the best of my knowledge and belief.

Vasili Kononov
(Signature of Registrant)

Subscribed and sworn to before me this 30th day of July, 1959.

My commission expires January 4, 1962

Antony A. Heath
(Notary Public)

(SEAL)

CERTIFICATE OF REGISTRATION

STATE OF OREGON

County of Marion } ss.

This is to certify that the foregoing Registration Statement was received in the office of the State Engineer on the 31st day of July, 1958, at 2:00 o'clock P.M. and has been duly recorded in said office in Book No. 13 of Registration Statements on page GR 3117

Witness my hand this 16th day of June, 1959.

Lewis A. Stanley
(State Engineer)

\$15.00

By _____ (Deputy)