

Registration Statement

RECEIVED
JAN 18 1960

CLAIMANT OF RIGHT TO APPROPRIATE GROUND WATER

STATE ENGINEER
BUREAU OF GEOL.

TO THE STATE ENGINEER OF OREGON:

I, C. V. MORRISON

of 922 S.W. 17th Ave - Portland County of Multnomah

State of Oregon do hereby make application for a certificate of registration as evidence of a right to appropriate ground water.

- 1. Source from which water is withdrawn is pump well
(Flowing well, pump well, infiltration trench, or tunnel)
- 2. Location is: 4 1/2 miles S.W. of Beaverton
(Approximate distance and direction from nearest city or town)

and is more particularly described as follows:

(a) 200 ft SE. of N.W. corner of SE 1/4 NE 1/4
(Give distance and bearing to corner of section or other legal subdivision)

being within Washington County of Sec. 30, Twp. 1 S, Rge. 1 W
(Name of legal subdivision) (N. or S.) (E. or W.)

or (b) within limits of recorded platted property, town or city: 720

in Lot _____, Block _____ of _____
(Name of plat or addition)

County of _____
(If within city or town, give name)

3. Construction Work was begun on Aug 1950; was completed on Sept 1950
(Date) (Date)

and the ground water claimed was first used for the purposes set out below on Feb. 7, 1951
(Date)

since which time the water has been used Continuously
(Continuously or intermittently)

from Feb 7, 1951 to present 7-29-58
(Date) (Date)

4. Quantity of water claimed and used is 10 (approx) gallons per minute; unknown acre feet per year.

5. Purpose or Purposes for which water is used exempt Domestic irrigation

(Domestic, irrigation, municipal, manufacturing, industrial, etc.)

6. Description of Well: Depth 305 feet. Type drilled
(Dug or drilled)

diameter 6 inches. Elevation of ground at well site 425 feet, mean sea level.
(As near as known)

Depth to water table 77.5 feet. 70' (static level)

7. Capacity of Well: 1.0 g.p.m. with 4.0 feet drawdown.
_____ g.p.m. with _____ feet drawdown.

Date of test Sept. 1950

If Flowing Well: Measured discharge _____ g.p.m. on _____
(Date)

Shut-in pressure at ground surface _____ lbs. per sq. in. on _____
(Date)

Water is controlled by _____
(Cap, valve, etc.)

If log of well is not available, give name and address of driller. L.W. Strayer

Sorrento Rd
Beaverton Oregon

11. Infiltration Trench: Covered or open _____
Dimensions: Length _____ ft. Minimum depth _____ ft. Maximum depth _____ ft.

Bottom width _____ ft. Discharge _____ g.p.m. Date of test _____

12. Tunnel: Type of lining _____

Dimensions: _____
(Length, course, and cross sectional size)

Position of water bearing stratum with reference to portal of tunnel _____

Log of tunnel: (Preceding table for log of well may be used, if desired. Give footage from portal and character of materials, as pertinent.)

13. Pumping Equipment:

(a) Pump Berksford - Submersible Capacity 12-15 g.p.m.
(Make, type and size)

(b) Motor 220 V PH 1 60 cy 2 H.P.
(Type and horsepower)

14. Location of area irrigated or to be irrigated, or place of use if for purposes other than irrigation:


Township North or South	Range E. or W. of Williams' Meridian	Section	Forty-acre Tract	Number Acres To Be Irrigated	Date of Reclamation
<u>1 S</u>	<u>1 W</u>	<u>30</u>	<u>SE 1/4 of NE 1/4</u>	<u>3 acres</u>	<u>1951</u>
<p>(3 Acres have been under actual irrigation plans contemplated for irrigation of the ^{the} at later date) <u>as C.V. Morrison 1-14-68</u></p>					
<p>I, <u>Carl V. Morrison & Dorothy A. Morrison</u> own jointly the entire <u>40⁰</u> tract noted above. The <u>20⁰</u> indicated on the map is under cultivation.</p>					
				<u>3⁰ Acres Total</u>	<u>C.V.M.</u>

15. If the ground water supply is supplemental to an existing water supply, identification of any application for a permit, permit, certificate or adjudicated right to appropriate water made or held by the registrant.

Not Supplemental

Township 1 S Range 1 W, W.M.
North

3 Acres

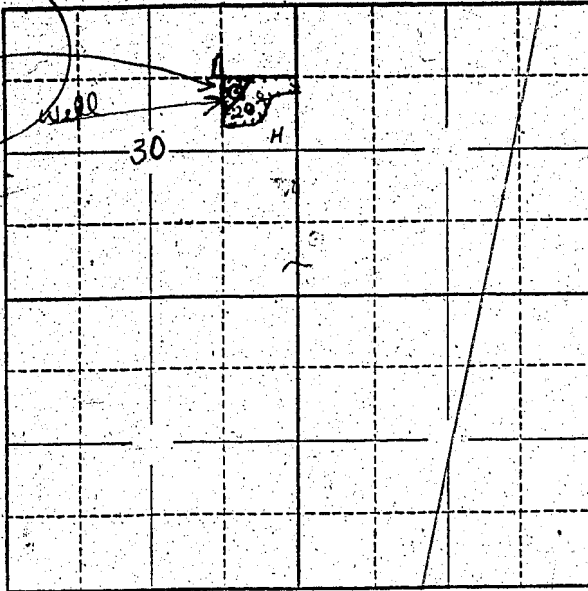

Locate well and acreage of irrigated land on plat:
Scale: 2" = 1 Mile

STATE OF OREGON

County of Multnomah } ss.

I, C. V. Morrison, being first duly sworn, do hereby certify that I have read the foregoing Registration Statement and that all of the items therein contained are true to the best of my knowledge and belief.

C. V. Morrison
(Signature of Registrant)

Subscribed and sworn to before me this 29th day of July, 1958

My commission expires March 18, 1961

Margaret R. [Signature]
(Notary Public)

(SEAL)

CERTIFICATE OF REGISTRATION

STATE OF OREGON

County of Marion } ss.

This is to certify that the foregoing Registration Statement was received in the office of the State Engineer on the 31st day of July, 1958, at 2:00 o'clock A. M. and has been duly recorded in said office in Book No. 16 of Registration Statements on page GR- 3919

Witness my hand this 15th day of February, 1960

Lewis A. Stanley
(State Engineer)

By _____ (Deputy)

1500