

# Registration Statement

## OF CLAIMANT OF RIGHT TO APPROPRIATE GROUND WATER

TO THE STATE ENGINEER OF OREGON:

I, Lester J. Kirk

of St. Route, Box 35, St. Paul County of Marión  
(Mailing address)

State of Oregon, do hereby make application for a certificate of registration as evidence of a right to appropriate ground water.

1. Source from which water is withdrawn is Pump well  
(Flowing well, pump well, infiltration trench, or tunnel)

2. Location is: 1/2 miles east of St. Paul  
(Approximate distance and direction from nearest city or town)

and is more particularly described as follows:

(a) 1300 feet west and 2600 feet north from S.E. corner section 20  
(Give distance and bearing to corner of section or other legal subdivision)  
being within N.W. 1/4 of S.W. 1/4 of Sec. 20, Twp. 4-S, Rge. 2 W.W.M  
(Smallest legal subdivision) (N. or S.) (E. or W.)

or (b) within limits of recorded platted property, town or city:

in Lot \_\_\_\_\_, Block \_\_\_\_\_ of \_\_\_\_\_  
(Name of plat or addition)

County of \_\_\_\_\_  
(If within city or town, give name)

3. Construction Work was begun on 8/15/51; was completed on 10/2/51  
(Date) (Date)

and the ground water claimed was first used for the purposes set out below on 21 April 1952  
(Date)

since which time the water has been used continuously during season  
(Continuously or intermittently)

from 10/2/51 to 10/1/57  
(Date) (Date)

4. Quantity of water claimed and used is 480 gallons per minute; \_\_\_\_\_ acre feet per year.

5. Purpose or Purposes for which water is used Irrigation

(Domestic, irrigation, municipal, manufacturing, industrial, etc.)

6. Description of Well: Depth 134 feet. Type Drilled  
(Dug or drilled)

diameter 18 inches. Elevation of ground at well site \_\_\_\_\_ feet, mean sea level.  
(As near as known)

Depth to water table 30 feet.

7. Capacity of Well: 440 g.p.m. with 76 feet drawdown.  
\_\_\_\_\_ g.p.m. with \_\_\_\_\_ feet drawdown?

Date of test \_\_\_\_\_

If Flowing Well: Measured discharge \_\_\_\_\_ g.p.m. on \_\_\_\_\_  
(Date)

Shut-in pressure at ground surface \_\_\_\_\_ lbs. per sq. in. on \_\_\_\_\_  
(Date)

Water is controlled by \_\_\_\_\_  
(Cap, valve, etc.)

8. Casing: (Give diameter, commercial specifications and depth below ground surface of each casing size.)

18 inch diameter steel casing from 0 to 134 feet  
 inch diameter from to feet  
 inch diameter from to feet  
 inch diameter from to feet

Describe and show depth of shoe, plug, adapter, liner or other details:  
 .....  
 .....

9. Perforated Casings or Screens:

screen perforated screen from 115 to 120  
 (Number per foot and size of perforations, or describe screen)  
 from to  
 from to  
 from to

10. Log of Well: (Describe each stratum or formation clearly, indicate if water bearing, and give thickness and depth as indicated.)

MATERIAL	Thickness (Feet)	Depth to Bottom (Feet)
134 ft. of 18 inch hole @ \$18.00-----	\$2,412.00	
Less-----	306.00	
Total-----	\$2,106.00	
Remarks. Casing set at 134 ft.		
Formation,		
0-51 broken		
51- 97 sand		
97-98 tough clay		
98-104 soft sandy clay		
104-112 fine sand		
112-128 coarse sand small gravel wood and streaks of clay.		
128-129 wood		
129-134 gravel, Well tested 140 gal. per. min. at 76 ft. draw down, test pump set at 115 ft.		

If log of well is not available, give name and address of driller. J. T. Miller

11. Infiltration Trench: Covered or open .....

Dimensions: Length ..... ft. Minimum depth ..... ft. Maximum depth ..... ft.

Bottom width ..... ft. Discharge ..... g.p.m. Date of test .....

12. Tunnel: Type of lining .....

Dimensions: .....  
(Length, course, and cross sectional size)

Position of water bearing stratum with reference to portal of tunnel .....

Log of tunnel: (Preceding table for log of well may be used, if desired. Give footage from portal and character of materials, as pertinent.)

13. Pumping Equipment:

(a) Pump ..... Turbine ..... Capacity ..... 500 ..... g.p.m.  
(Make, type and size)


(b) Motor ..... 30 HP .....  
(Type and horsepower)

14. Location of area irrigated or to be irrigated, or place of use if for purposes other than irrigation.

Township North or South	Range E. or W. of Willamette Meridian	Section	Forty-acre Tract	Number Acres To Be Irrigated	Date of Reclamation
N.S.	SW	20	NE $\frac{1}{4}$ of NW $\frac{1}{4}$	2.	21 April 52
"	"	"	NE $\frac{1}{4}$ of NE $\frac{1}{4}$	0.5	"
"	"	"	SW $\frac{1}{4}$ of NW $\frac{1}{4}$	21.	"
"	"	"	SW $\frac{1}{4}$ of NW $\frac{1}{4}$	30	"
"	"	"	NE $\frac{1}{4}$ of SW $\frac{1}{4}$	23.	"
"	"	"	SW $\frac{1}{4}$ of SW $\frac{1}{4}$	9	"
"	"	"	NE $\frac{1}{4}$ of SW $\frac{1}{4}$	20	"
"	"	"	SE $\frac{1}{4}$ of SW $\frac{1}{4}$	11	"
"	"	"	NW $\frac{1}{4}$ of SE $\frac{1}{4}$	18	"
"	"	"	SW $\frac{1}{4}$ of SE $\frac{1}{4}$	11	"
				<u>145.5</u>	"

15. If the ground water supply is supplemental to an existing water supply, identification of any application for a permit, permit, certificate or adjudicated right to appropriate water made or held by the registrant.

Township 45 Range 2W, W.M.  
North

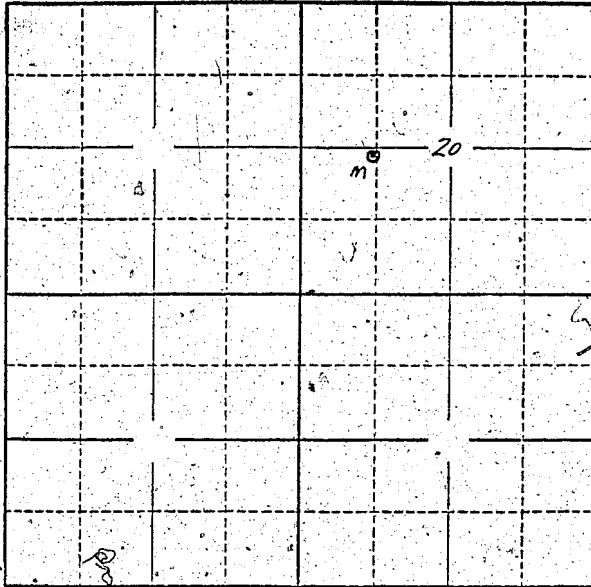

Locate well and acreage of irrigated land on plat.  
Scale: 2" = 1 Mile

STATE OF OREGON

County of Marion } ss.

I, Lester J. Kirk, being first duly sworn, do hereby certify that I have read the foregoing Registration Statement and that all of the items therein contained are true to the best of my knowledge and belief.

Lester J. Kirk  
(Signature of Registrant)

Subscribed and sworn to before me this 31st day of July, 1958.

My commission expires 12th June 1961 Wm. S. Bartholomew  
(Notary Public)

(SEAL)

**CERTIFICATE OF REGISTRATION**

STATE OF OREGON

County of Marion } ss.

This is to certify that the foregoing Registration Statement was received in the office of the State Engineer, on the 31 day of July, 1958, at 11:30 o'clock A. M. and has been duly recorded in said office in Book No. 13 of Registration Statements on page GR-3118

Witness my hand this 16th day of June, 1959

Laura A. Stanley  
(State Engineer)

By \_\_\_\_\_  
(Deputy)

GR - 3118

\$ 27.80