

Registration Statement

OF CLAIMANT OF RIGHT TO APPROPRIATE GROUND WATER

TO THE STATE ENGINEER OF OREGON:

I, Calvin J. Blain
 of P.O. Box 302 Siles County of Curry
(Mailing address) CITY
 State of Oregon, do hereby make application for a certificate of registration as evidence of a right to appropriate ground water.

1. Source from which water is withdrawn is open sump well
(Flowing well, pump well, infiltration trench, or tunnel)
2. Location is: 1 1/2 mile West of US 101 on Airport Rd.
(Approximate distance and direction from nearest city or town)

and is more particularly described as follows:

(a) About 1200 feet east & 150 feet north from W 1/4 corner Section 32
(Give distance and bearing to corner of section or other legal subdivision)
 being within S 1/4 NW 1/4 of Sec. 32, Twp. 31 S, Rge. 15 W
(Smallest legal subdivision) (N. or S.) (E. or W.)
 or (b) within limits of recorded platted property, town or city:
 in Lot _____, Block _____ of _____
(Name of plat or addition)
 County of Curry
(If within city or town, give name)

3. Construction Work was begun on AUGUST 1949; was completed on SEPT 1949
(Date) (Date)
 and the ground water claimed was first used for the purposes set out below on SEPT 1949
(Date)
 since which time the water has been used EACH IRRIGATION SEASON
(Continuously or intermittently)
 from 1949 to PRESENT
(Date) (Date)

4. Quantity of water claimed and used is 400 gallons per minute; 8 acre feet per year.


5. Purpose or Purposes for which water is used IRRIGATION OF CRANBERRY Bog

6. Description of Well: Depth 12 feet. Type DRAGLINE SUMP
(Dug or drilled)
 diameter 25 x 45 inches. Elevation of ground at well site _____ feet, mean sea level.
(As near as known)
 Depth to water table 9 feet.

7. Capacity of Well: 400 g.p.m. with 1 feet drawdown, 1 hr to 1 hr. 30 min.
 _____ g.p.m. with _____ feet drawdown.

Date of test NONE
 If Flowing Well: Measured discharge _____ g.p.m. on _____
(Date)
 Shut-in pressure at ground surface _____ lbs. per sq. in. on _____
(Date)
 Water is controlled by _____
(Cap, valve, etc.)

Township 3/S Range 15W W.M.
North

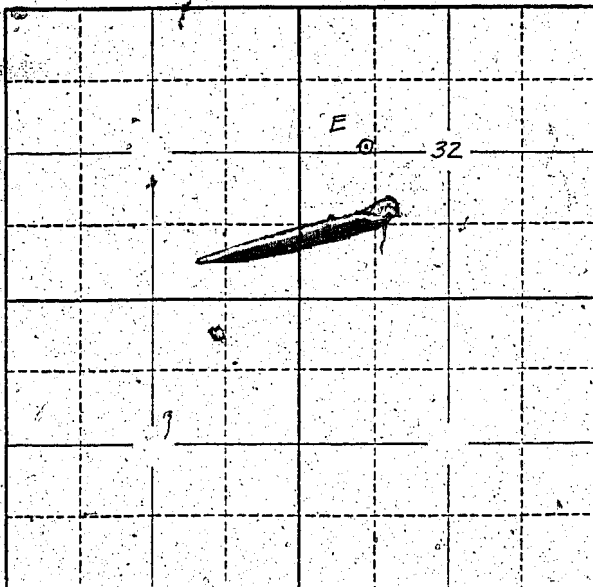

Locate well and acreage of irrigated land on plat.
Scale: 2" = 1 Mile

STATE OF OREGON

County of Marion } ss.

I, Calvin Blair, being first duly sworn, do hereby certify that I have read the foregoing Registration Statement and that all of the items therein contained are true to the best of my knowledge and belief.

Calvin Blair
(Signature of Registrant)

Subscribed and sworn to before me this 31st day of July, 1958

My commission expires 12th June 1961

Wm. D. Bartholomew
(Notary Public)

(SEAL)

CERTIFICATE OF REGISTRATION

STATE OF OREGON

County of Marion } ss.

This is to certify that the foregoing Registration Statement was received in the office of the State Engineer on the 31st day of July, 1958, at 12:20 ^{noon} o'clock P.M. and has been duly recorded in said office in Book No. 13 of Registration Statements on page GR 3121

Witness my hand this 16th day of June, 1959

Lewis A. Stanley
(State Engineer)

By _____
(Deputy)

GR - 3121

\$15.00