

Registration Statement

OF CLAIMANT OF RIGHT TO APPROPRIATE GROUND WATER

TO THE STATE ENGINEER OF OREGON:

I, THE BOILERMAKER'S BUILDING ASSOCIATION

of 1313 S.W. THIRD AVENUE PORTLAND County of MULTNOMAH

State of OREGON, do hereby make application for a certificate of registration as evidence of a right to appropriate ground water.

1. Source from which water is withdrawn is Pump well
(Flowing well, pump well, infiltration trench, or tunnel)

2. Location is: 1313 SW Third Avenue, Portland, Oregon
(Appropriate distance and direction from nearest city or town)

and is more particularly described as follows:

(a) NORWEST OREGON * About 1900 feet South & 1200 feet east from NW Corner Section 3
(Give distance and bearing to corner of section or other legal subdivision)

being within PORTLAND of Sec. 3, Twp. 1 SOUTH, Rge. 1 EAST
(Smallest legal subdivision) (N. or S.) (E. or W.)

or (b) within limits of recorded platted property, town or city: PORTLAND

in Lot 2 & 3, Block 147 of PORTLAND
(Name of plat or addition)

PORTLAND County of MULTNOMAH
(If within city or town, give name)

3. Construction Work was begun on approx. April 1942; was completed on July 18, 1942
(Date) (Date)

and the ground water claimed was first used for the purposes set out below on approx May, 1943
(Date)

since which time the water has been used intermittently, as required for space cooling
(Continuously or intermittently)

from May 1943 to present date
(Date) (Date)

4. Quantity of water claimed and used is 200 gallons per minute; acre feet per year.

5. Purpose or Purposes for which water is used air-conditioning the building at the above address.
(Domestic, irrigation, municipal, manufacturing, industrial, etc.)

6. Description of Well: Depth 151 feet. Type drilled
(Dug or drilled)
diameter 10 inches. Elevation of ground at well site approx 100 feet, mean sea level.
(As near as known)
Depth to water table 56 feet. static level.

7. Capacity of Well: 200 g.p.m. with 27 feet drawdown.
 g.p.m. with feet drawdown.


Date of test July 18, 1942

If Flowing Well: Measured discharge g.p.m. on
(Date)

Shut-in pressure at ground surface lbs. per sq. in. on
(Date)

Water is controlled by
(Cap, valve, etc.)

Township 15 Range 1E, W.M.
North

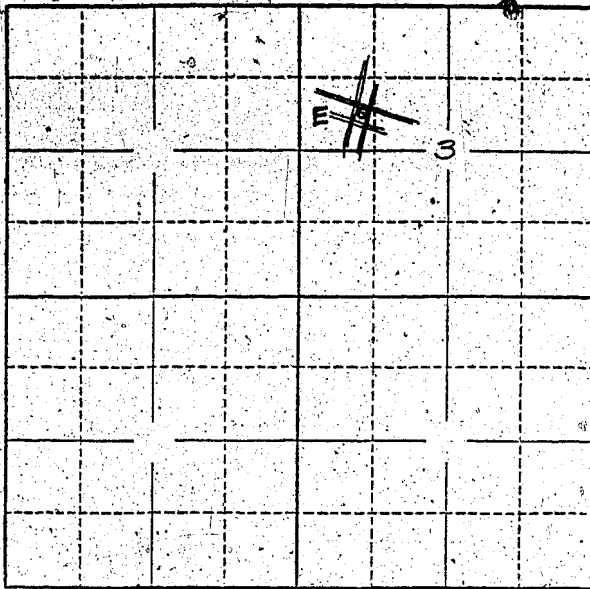

Locate well and acreage of irrigated land on plat.
Scale: 2" = 1 Mile

STATE OF OREGON }
County of MULTNOMAH } ss.

I, JAMES A. GEHRIG, being first duly sworn, do hereby certify that I have read the foregoing Registration Statement and that all of the items therein contained are true to the best of my knowledge and belief.

James A. Gehrig Sec-Treas.
(Signature of Registrant) Lodge #72

Subscribed and sworn to before me this 29th day of JULY, 1958

My commission expires JUNE 5, 1959

Verdy J. ...
(Notary Public)

(SEAL)

CERTIFICATE OF REGISTRATION

STATE OF OREGON }
County of Marion } ss.

This is to certify that the foregoing Registration Statement was received in the office of the State Engineer on the 31st day of July, 1958, at 2:00 o'clock A. M. and has been duly recorded in said office in Book No. 16 of Registration Statements on page GR 3903

Witness my hand this 15th day of February, 1960

Laura A. Stanley
(State Engineer)

By _____
(Deputy)

\$ 20.00